


29566

35-5-21

T.35S. R.5W. W.M.

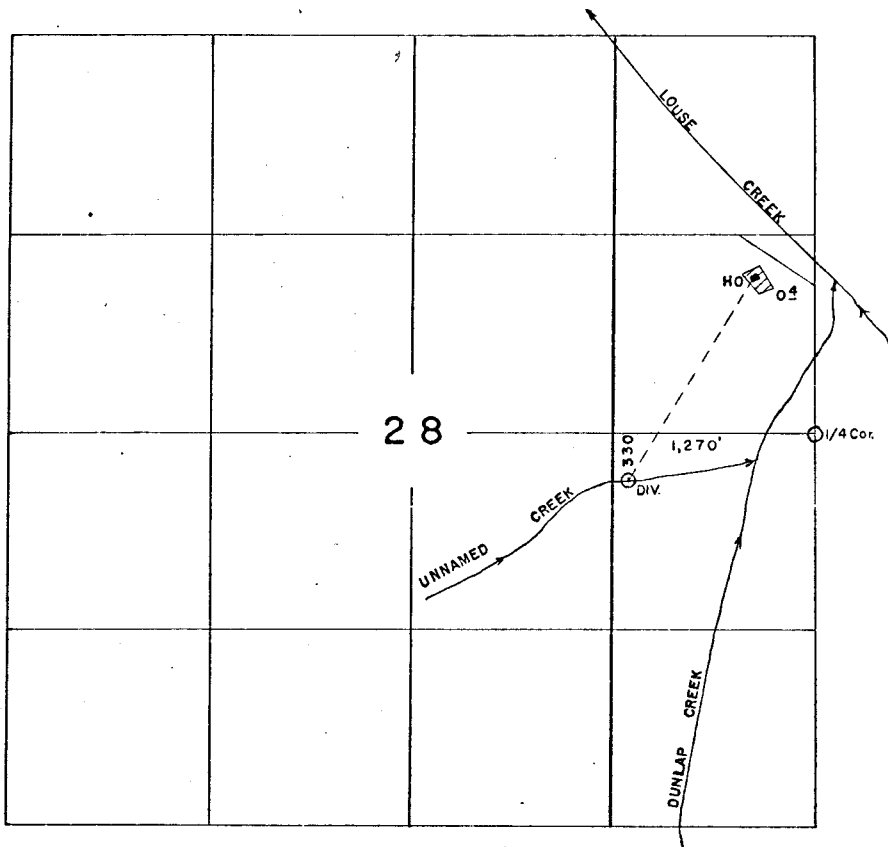

FINAL PROOF SURVEY UNDER

Application No. 39752... Permit No. 29566...
IN NAME OF

..... EVERETT L. BURCH

Surveyed MAY 3... 1968, by R.B. STEIMER.....