


38-8-10~~H~~  
29660

T. S. S. 103 1000. 10

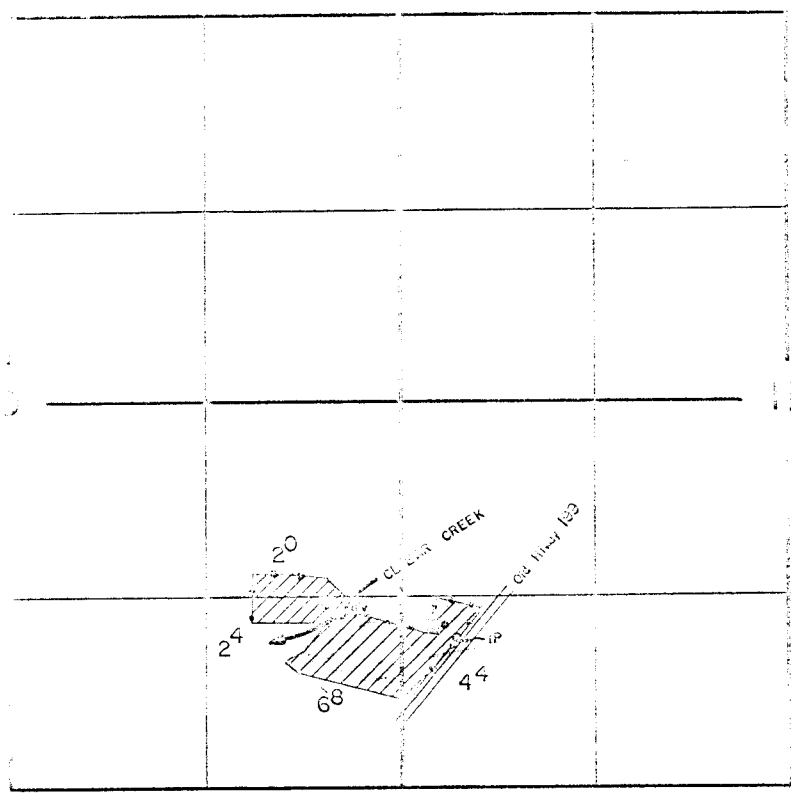

*73-10-10-10*


**FINAL PROOF SURVEY**  
UNDER

Application No. 39043.. Permit No. 29660..  
IN NAME OF

Fred C. Patricia Krause — David M. C. Mary P. Lloyd...

Surveyed Feb. 20... 1935., by ... R. Steiner...

# T. 38 S., R. 8 W., W. M.

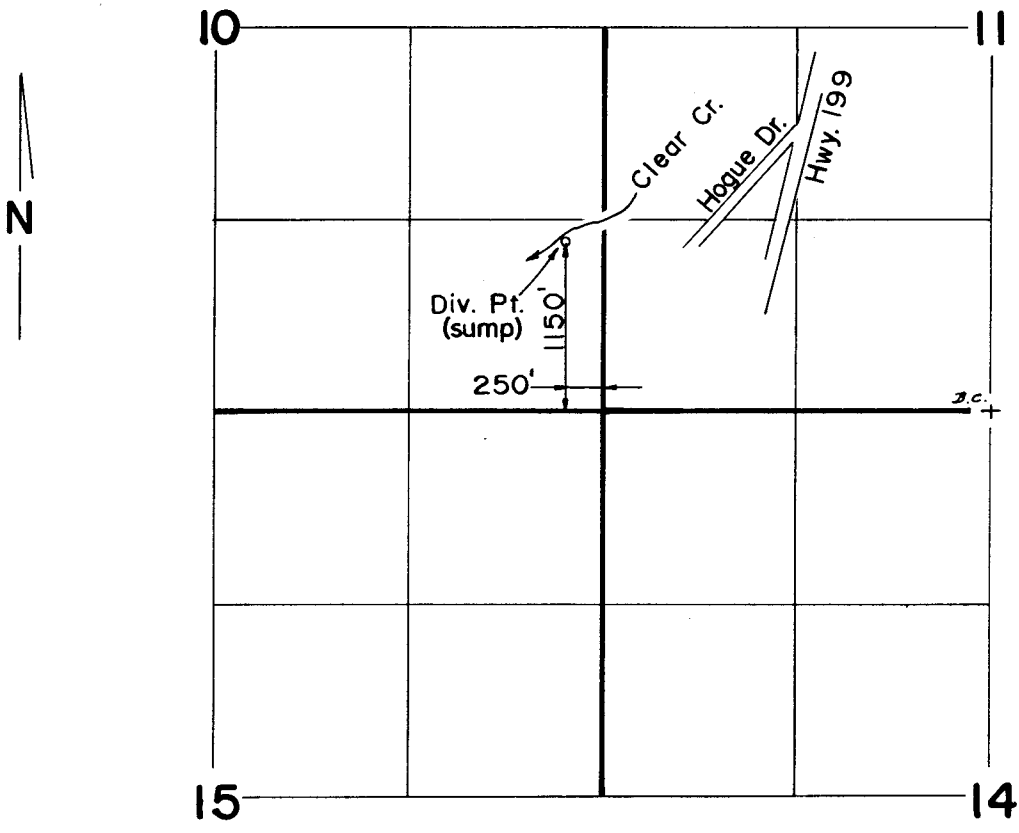

Scale: 1" = 1320'

## FINAL PROOF SURVEY

UNDER

TRANSFER NO. 5000

*CERT. 73992*

Application No. .... Permit No. ....

IN NAME OF

.....**DAVID J. HARTSVELDT**.....

Surveyed JUN...9... 19.86, by B....S...JAMES...