


29675

37-5-4

T.39S. R.5W. W.M.

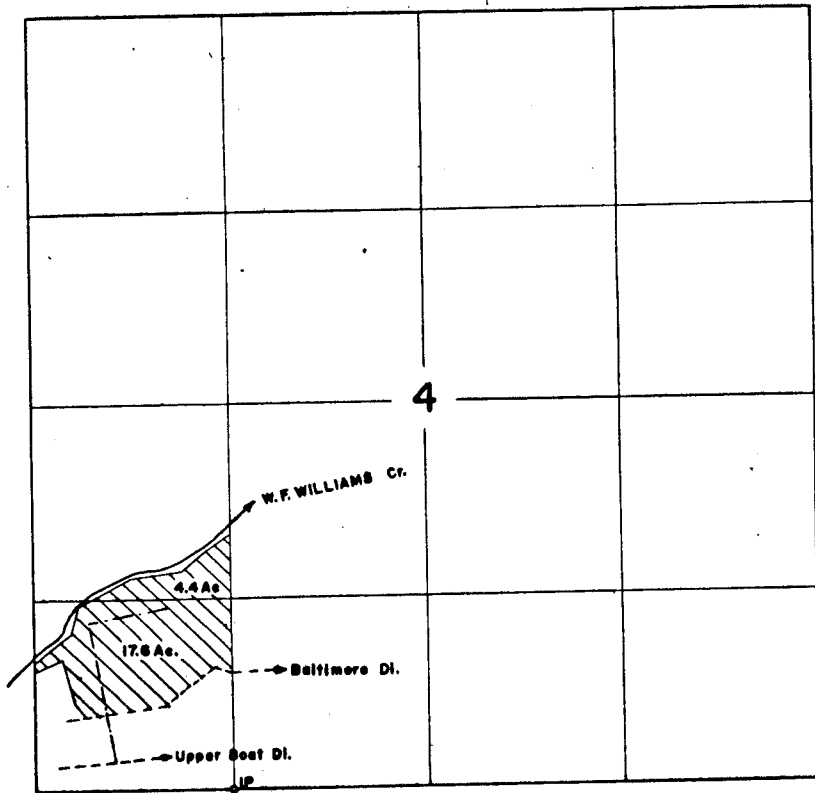

NE 1/4 NW 1/4 SEC. 8

WEST FORK WILLIAMS CR
DIV. PT.

DIV. PT. LOCATED
5340' W AND
820' S. FROM NW 1/4
COR. SEC. 8
PT. 1865 B

UPPER BOAT DITCH

FINAL PROOF SURVEY UNDER

Application No. 39868... Permit No. 29675...
IN NAME OF

JAMES L. LATHROP

Surveyed OCT. 9. 1968, by R.B. Steimer.....