


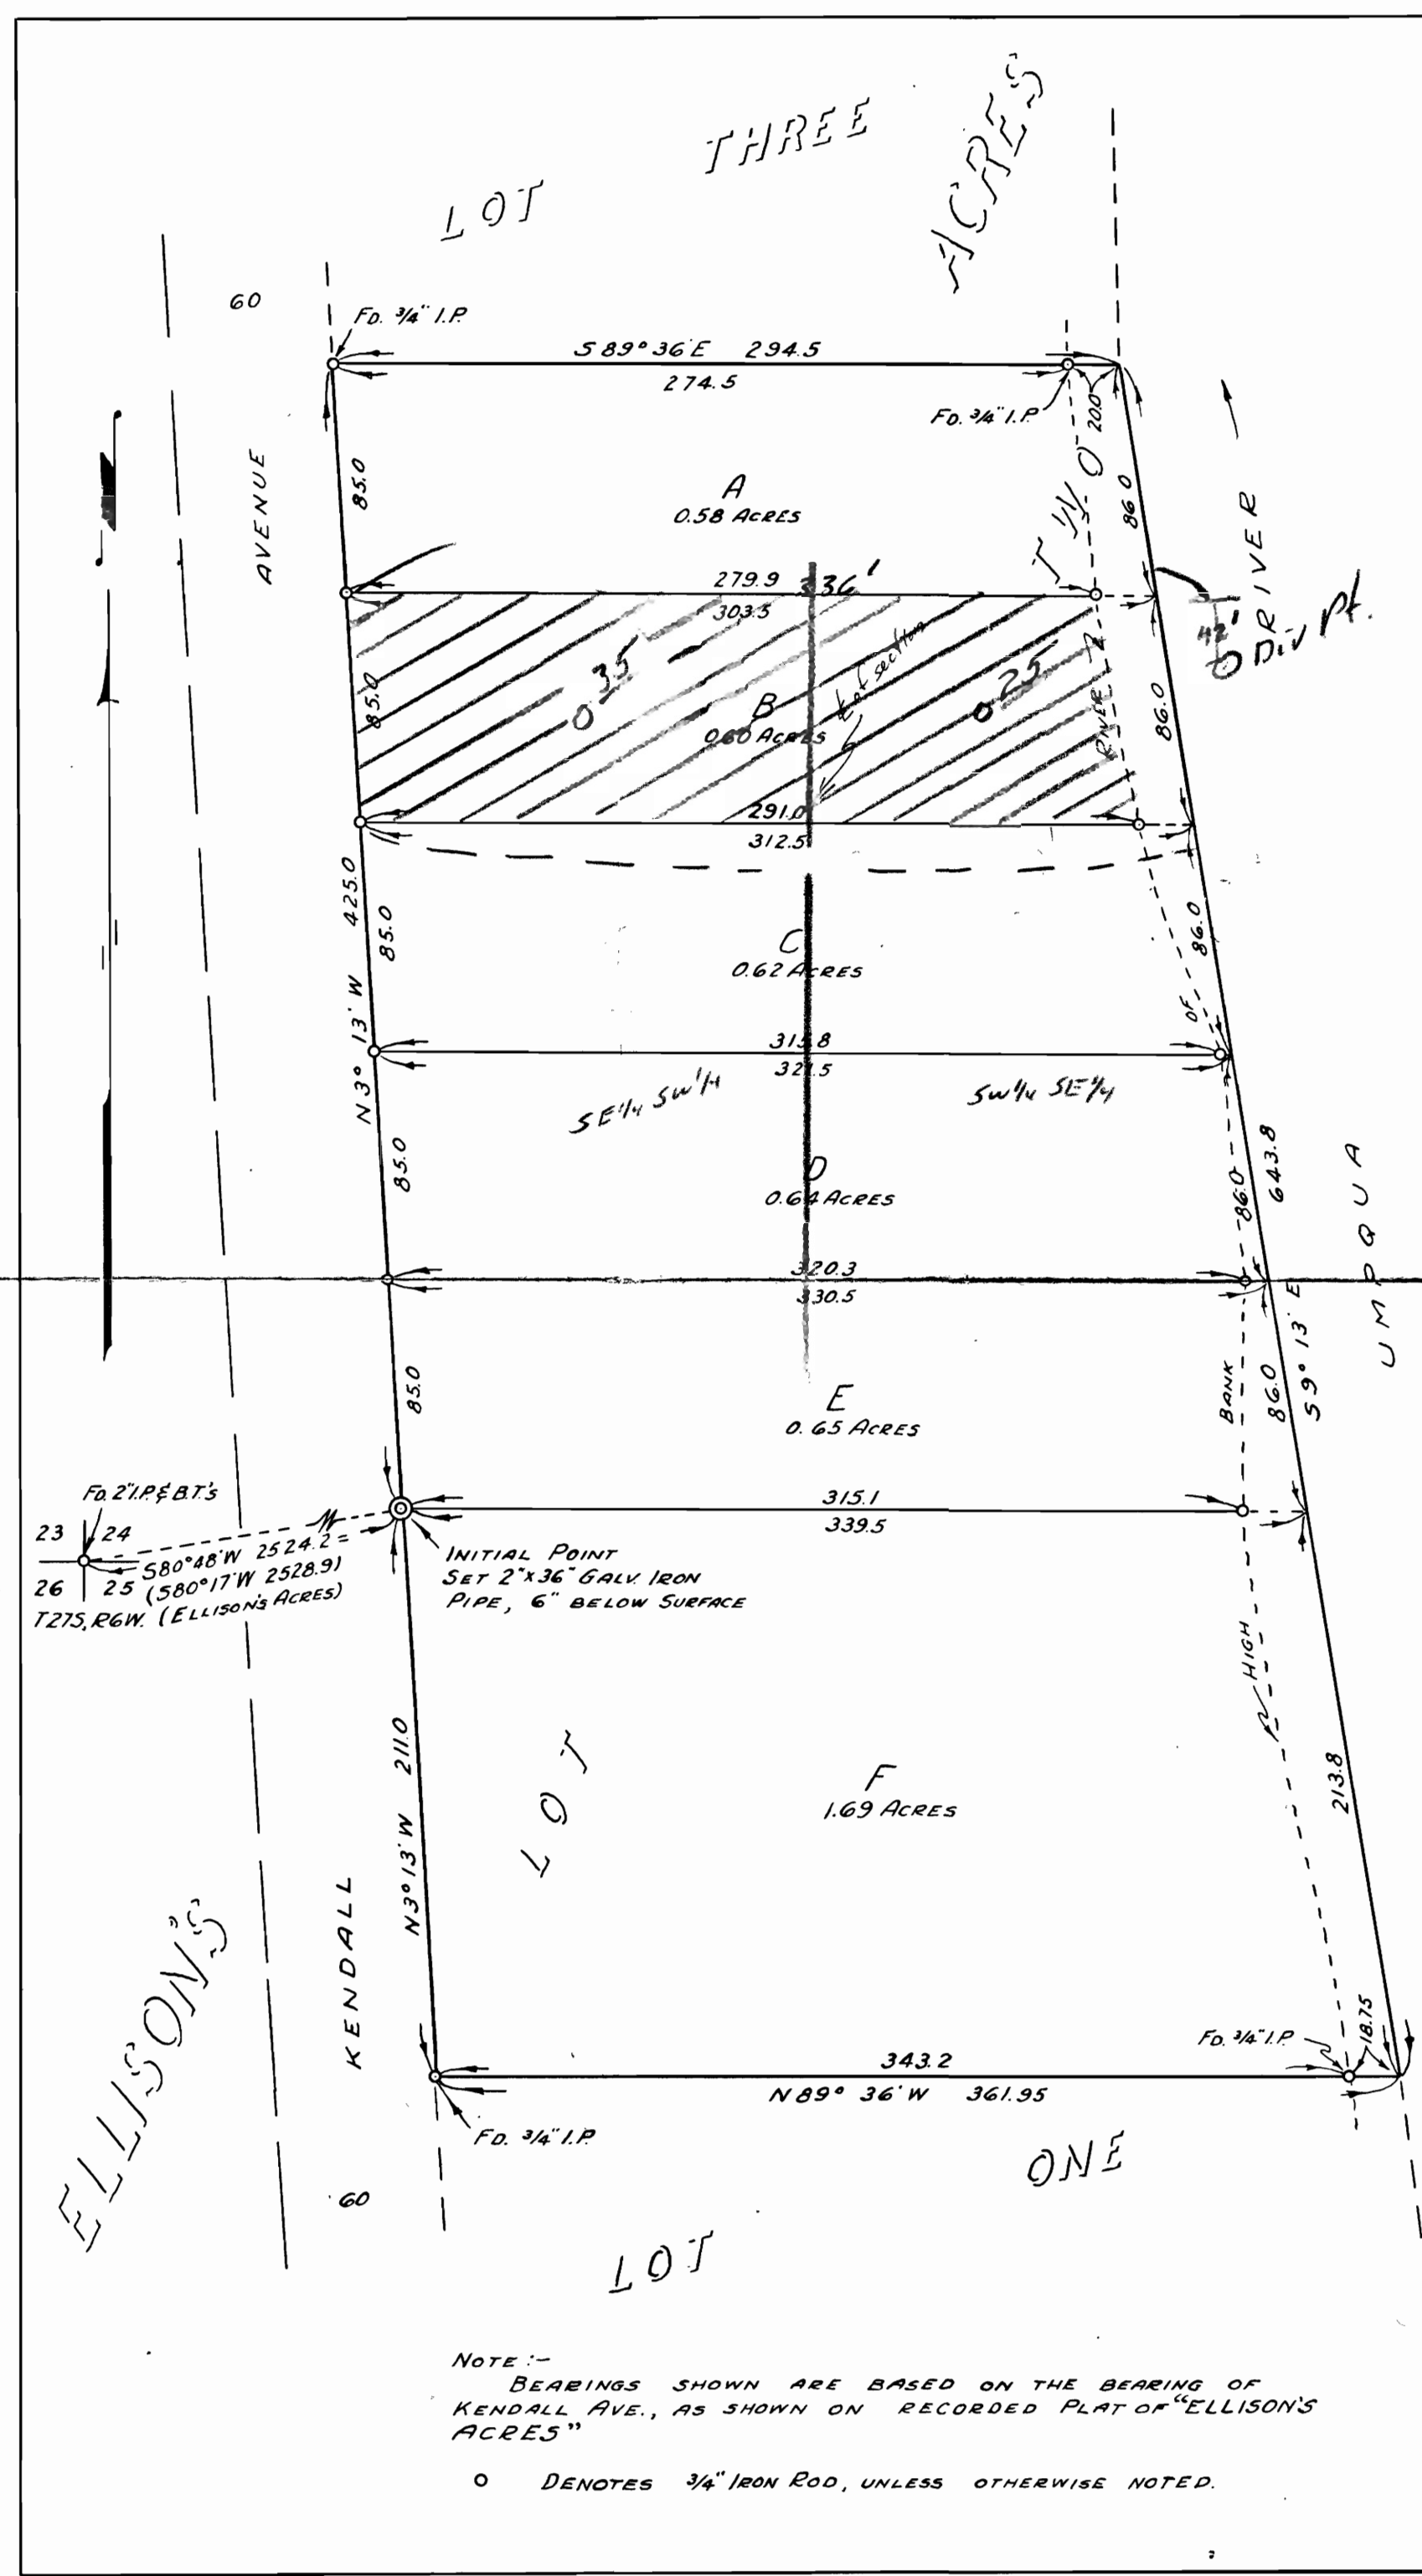

UMPQUA TERRACE

A SUBDIVISION OF LOT 2, ELLISON'S ACRES.

BEN. B. IRVING
ROSEBURG, OREGON
SCALE 1" = 60'

REG. CIVIL ENGINEER

BY ORDER OF THE COUNTY COURT
APPROVED March 29 1951
COUNTY JUDGE
L. B. Beckley
COMMISSIONER

APPROVED MARCH 27 1951
COUNTY ASSESSOR
Ed. Ainsworth

BY ORDER OF THE CITY PLANNING COMMISSION
APPROVED March 26 1951
PRESIDENT
Fred B. Garrison
SECRETARY
Mrs. Wright

APPROVED March 29 1951
COUNTY SURVEYOR
Ben B. Irving

CERTIFICATE OF SURVEYOR

STATE OF OREGON) S.S.
COUNTY OF DOUGLAS)
I, BEN B. IRVING, BEING FIRST DULY SWORN, DEPOSE AND SAY THAT I HAVE CORRECTLY SURVEYED AND MARKED WITH PROPER MONUMENTS, THE LANDS DELINEATED ON THE ANNEXED PLAT, OF WHICH THE FOLLOWING IS A TRUE AND CORRECT DESCRIPTION: - BEGINNING AT THE INITIAL POINT, A 2"x36" GALV. IRON PIPE, 6" BELOW SURFACE, IN THE EASTERLY R/W LINE OF KENDALL AVE. AND THE WESTERLY LINE OF LOT 2, ELLISON'S ACRES, AS PLATTED AND FILED IN THE OFFICE OF THE COUNTY CLERK OF DOUGLAS COUNTY, OREGON, FROM WHICH PIPE THE CORNER TO SECTIONS 23, 24, 25, 26, T27S, R6W, WM BEARS S 80° 48' W 2524.2 FT.; THENCE N 3° 13' W 425.0 FT. ALONG SAID R/W AND LOT LINE, TO A FD. 3/4" I.P. PIPE AT THE NW CORNER OF SAID LOT 2; THENCE S 89° 36' E, ALONG THE LINE BETWEEN LOTS 2, & 3, SAID ELLISON'S ACRES, 274.5 FT. TO A FD. 3/4" I.P. PIPE ON THE HIGH BANK OF THE SOUTH UMPQUA RIVER, AND CONTINUING 20.0 FT. TO THE NE COR. OF SAID LOT 2, BEING ON THE LEFT BANK OF SAID RIVER; THENCE S 9° 13' E 643.8 FT., UPSTREAM, ALONG SAID LEFT BANK OF RIVER, TO THE S.E. CORNER OF SAID LOT 2; THENCE N 89° 36' W 187.5 FT., ALONG THE LINE BETWEEN LOTS 1 & 2, SAID ELLISON'S ACRES, TO A 3/4" I.P. PIPE ON THE HIGH BANK OF SAID RIVER, AND CONTINUING 343.2 FT. TO A FD. 3/4" I.P. PIPE AT THE S.W. CORNER OF SAID LOT 2; THENCE N 3° 13' W 211.0 FT., ALONG THE EASTERLY R/W LINE OF KENDALL AVE. & WESTERLY LINE OF SAID LOT 2, TO THE POINT OF BEGINNING, CONTAINING 4.78 ACRES, MORE OR LESS, IN SECTION 24, T27S, R6W, WM, DOUGLAS COUNTY, OREGON.

OREGON No 240
Nov. 8, 1919

SUBSCRIBED AND SWORN TO BEFORE ME THIS 19th DAY OF March 1951

Ben B. Irving
BEN B. IRVING
REG. PROFESSIONAL ENGINEER

Roy Agee
ROY AGEE
COUNTY CLERK.

DEDICATION

KNOW ALL MEN BY THESE PRESENTS: THAT WE, RALPH A. VOELLER AND MARIAN E. VOELLER, HUSBAND AND WIFE, OWNERS OF THE LANDS REPRESENTED AND DESCRIBED ON THE ANNEXED PLAT, HAVE CAUSED THE SAME TO BE SURVEYED AND PLATTED BY THE NAME OF "UMPQUA TERRACE".

IN TESTIMONY WHEREOF, THE SAID RALPH A. VOELLER AND MARIAN E. VOELLER HAVE HEREUNTO SET THEIR HANDS THIS 1st DAY OF FEBRUARY 1951.

Ralph A. Voeller
RALPH A. VOELLER

Marian E. Voeller
MARIAN E. VOELLER

ACKNOWLEDGEMENT

STATE OF OREGON) S.S.
COUNTY OF DOUGLAS)
ON THE 1st DAY OF February 1951, BEFORE ME APPEARED RALPH A. VOELLER AND MARIAN E. VOELLER, TO ME PERSONALLY KNOWN, WHO BEING DULY SWORN, DID SAY THAT THEY ARE THE LAWFUL OWNERS OF THE TRACT OF LAND DELINEATED ON THE ANNEXED PLAT, AND THAT THEY DO HEREBY ACKNOWLEDGE THAT THEY SIGNED THE ACCOMPANYING DEDICATION AS THEIR FREE AND VOLUNTARY ACT AND DEED.

IN TESTIMONY WHEREOF, I HAVE HEREUNTO SET MY HAND AND AFFIXED MY OFFICIAL SEAL THIS DAY AND YEAR ABOVE WRITTEN.

Roy Agee
ROY AGEE
COUNTY CLERK.

STATE OF OREGON) S.S.
COUNTY OF DOUGLAS)
I, BEN B. IRVING, BEING DULY SWORN, DEPOSE AND SAY UPON OATH: - THAT I AM THE SURVEYOR WHO MADE THE SURVEY AND PREPARED THE FINAL MAP OF "UMPQUA TERRACE" AND THAT THE FOREGOING TRACING IS AN EXACT COPY OF THE MAP OF SAID "UMPQUA TERRACE".

Ben B. Irving
BEN B. IRVING
REG. CIVIL ENGINEER

SUBSCRIBED AND SWORN TO BEFORE ME THIS 19th DAY OF March 1951.

Roy Agee
ROY AGEE
COUNTY CLERK.

STATE OF OREGON) S.S.
COUNTY OF DOUGLAS)
I, ROY AGEE, COUNTY CLERK OF DOUGLAS COUNTY, OREGON, DO HEREBY CERTIFY THAT THE WITHIN COPY OF PLAT HAS BEEN BY ME COMPARED WITH THE ORIGINAL THEREOF AND THAT IT IS AN EXACT COPY OF THE WHOLE THEREOF, AS THE SAME APPEARS ON FILE IN MY OFFICE AND CUSTODY.

29th DAY OF March 1951

WITNESS MY HAND AND OFFICIAL SEAL THIS DAY

Roy Agee
ROY AGEE
COUNTY CLERK.

RECEIVED
JUL 21 1963
STAFF CLERK
JUL 21 1963

FILED March 29th 1951
Roy Agee
COUNTY CLERK.