


Per. 29719

37-8-16

T.39S. R.8W.W.M.

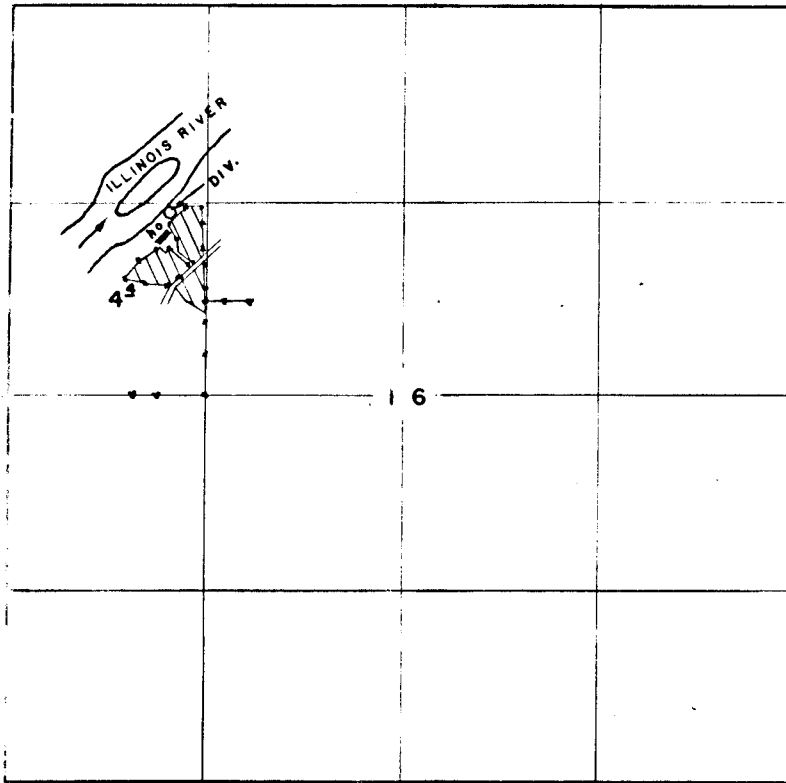

Div. 1040' S. and 4200' W. from N.E. Sec. Cor.

FINAL PROOF SURVEY
UNDER

Application No. 39929... Permit No. 29719...
IN NAME OF

..... WILMER T. WHITE

Surveyed NOV. 7..... 19 67., by R. B. STEIMER.....