


T.33S.R.6W.W.M.

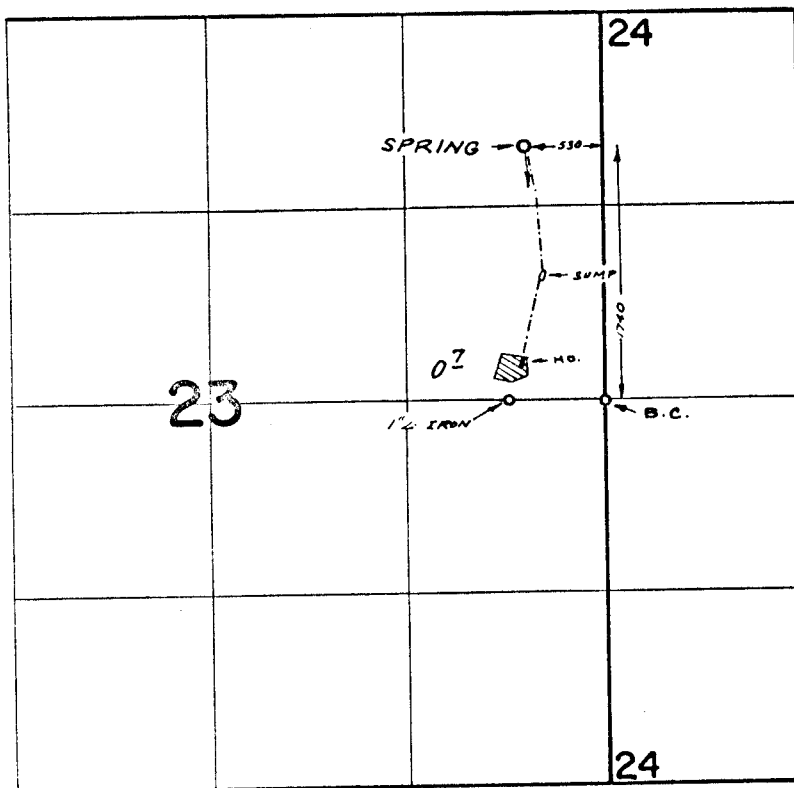

FINAL PROOF SURVEY UNDER

Application No. 39940... Permit No. 29727...
IN NAME OF

LESLIE L. & MARY L. COX

Surveyed APR. 28, 1970., by R. MUCKEN.