


Per. 29746
35-7-11

T.35 S. R.7 W. W.M.

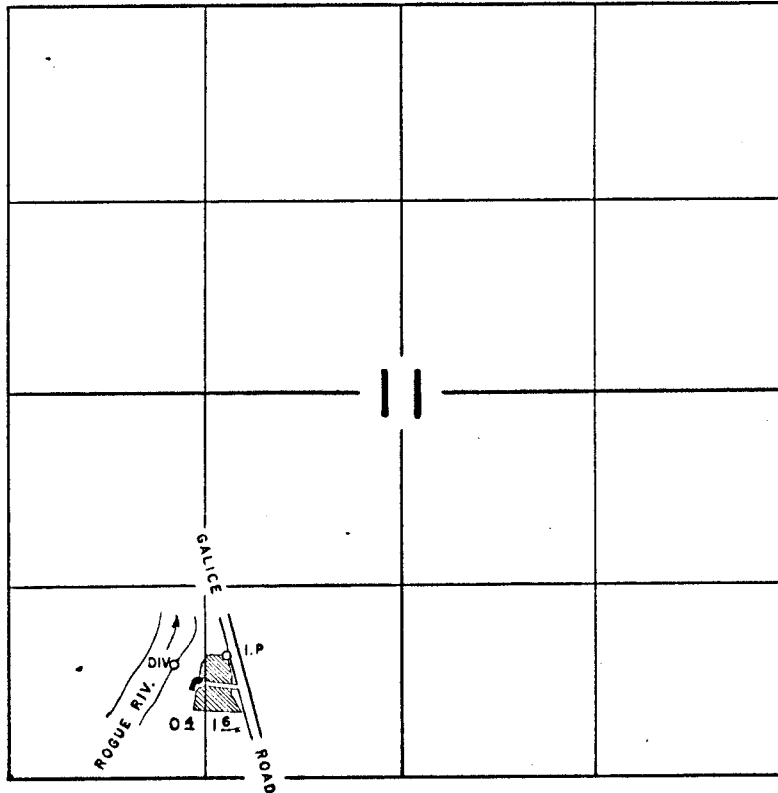

Div. Pt. located 1120' E. & 770' N. from S.W. Cor. Sec. 11

FINAL PROOF SURVEY UNDER

Application No. 39976 Permit No. 29746
IN NAME OF

TODD & EDITH C. GILMORE

Surveyed May 23, 1967, by R.B. STEIMER