


29952 15

3-21

T. 35 S. R. 5 W. W. M.

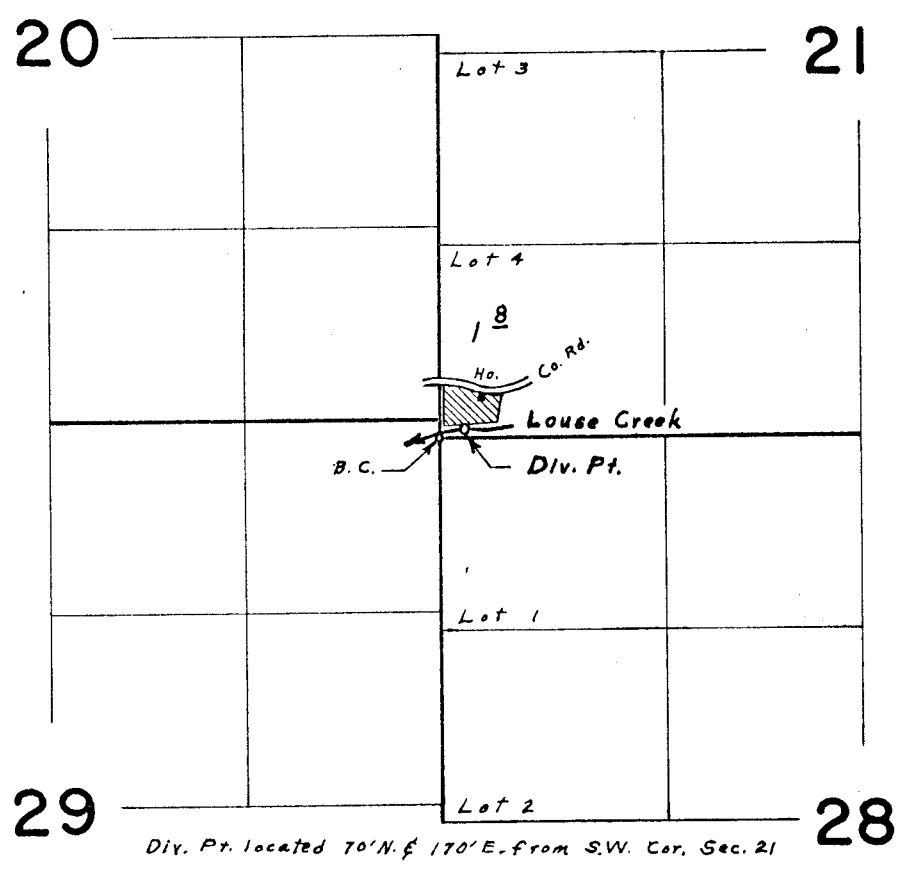

FINAL PROOF SURVEY

UNDER

Application No. 40187 Permit No. 29952

IN NAME OF

RUFUS M. HAGER

Surveyed April 14, 1970, by L. E. Gould