


TOWNSHIP 34 S, RANGE 6 W. W.M. # 29964  
SE 1/4 SEC 23.

Scale 1 inch = 500 ft.

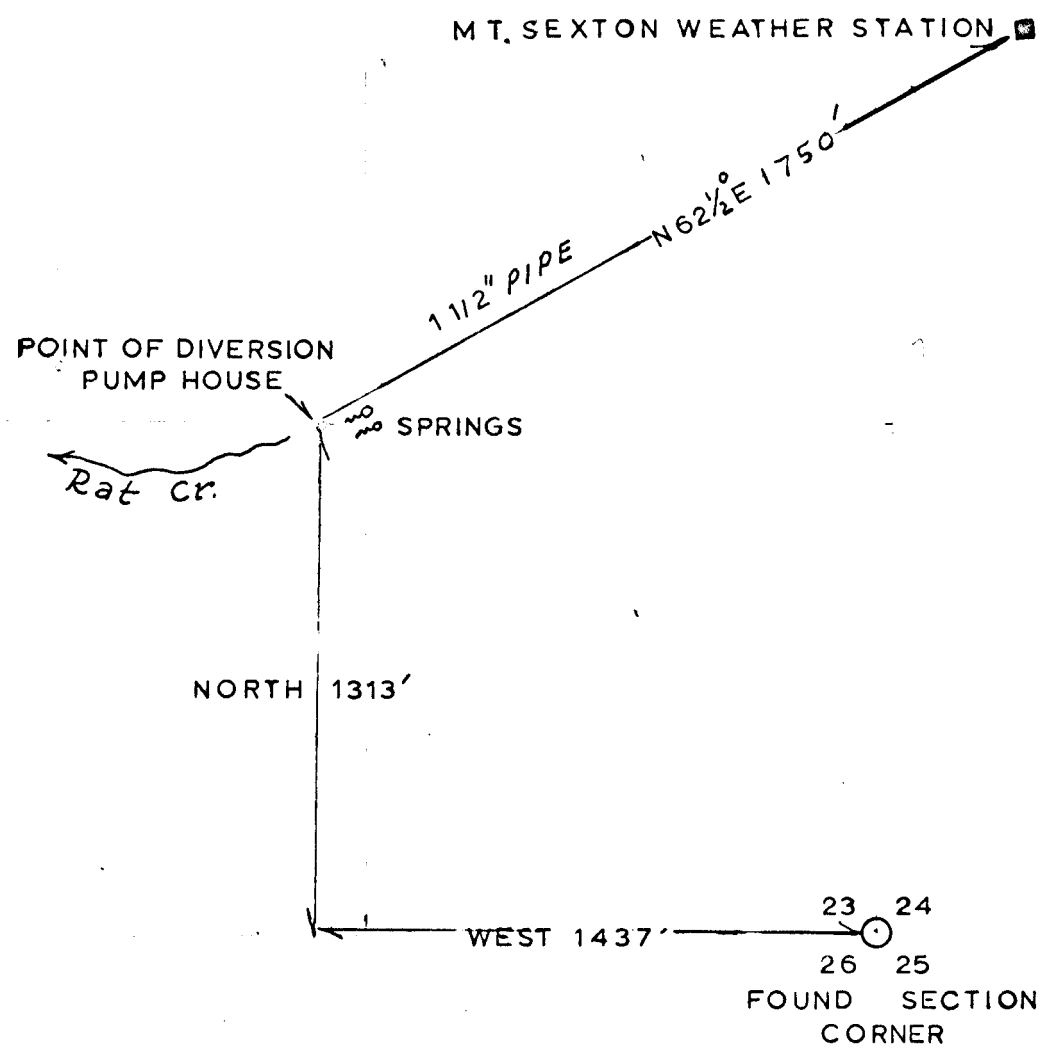

Oct. 1964

Application No. 40404  
Permit No. 29964