


30001
R-4492

TESS. RT. W. RR.

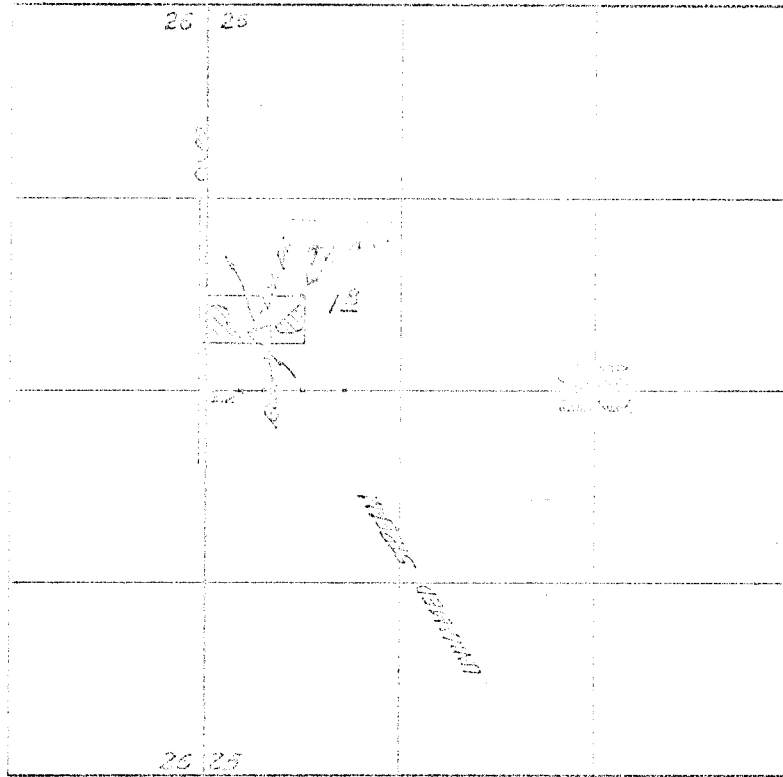

DM pt. located 420 feet N. and 350 feet E.
from the NW corner of section 25

FINAL PROOF SURVEY
UNDER

R-40224 R-4492
Application No. 40225 Permit No. 30001
IN NAME OF

HERMAN J. DALEY

Surveyed May 25, 1967, by V. Garner