


Sec. 3. T<sub>4</sub>. 39 S. R. 6- W-

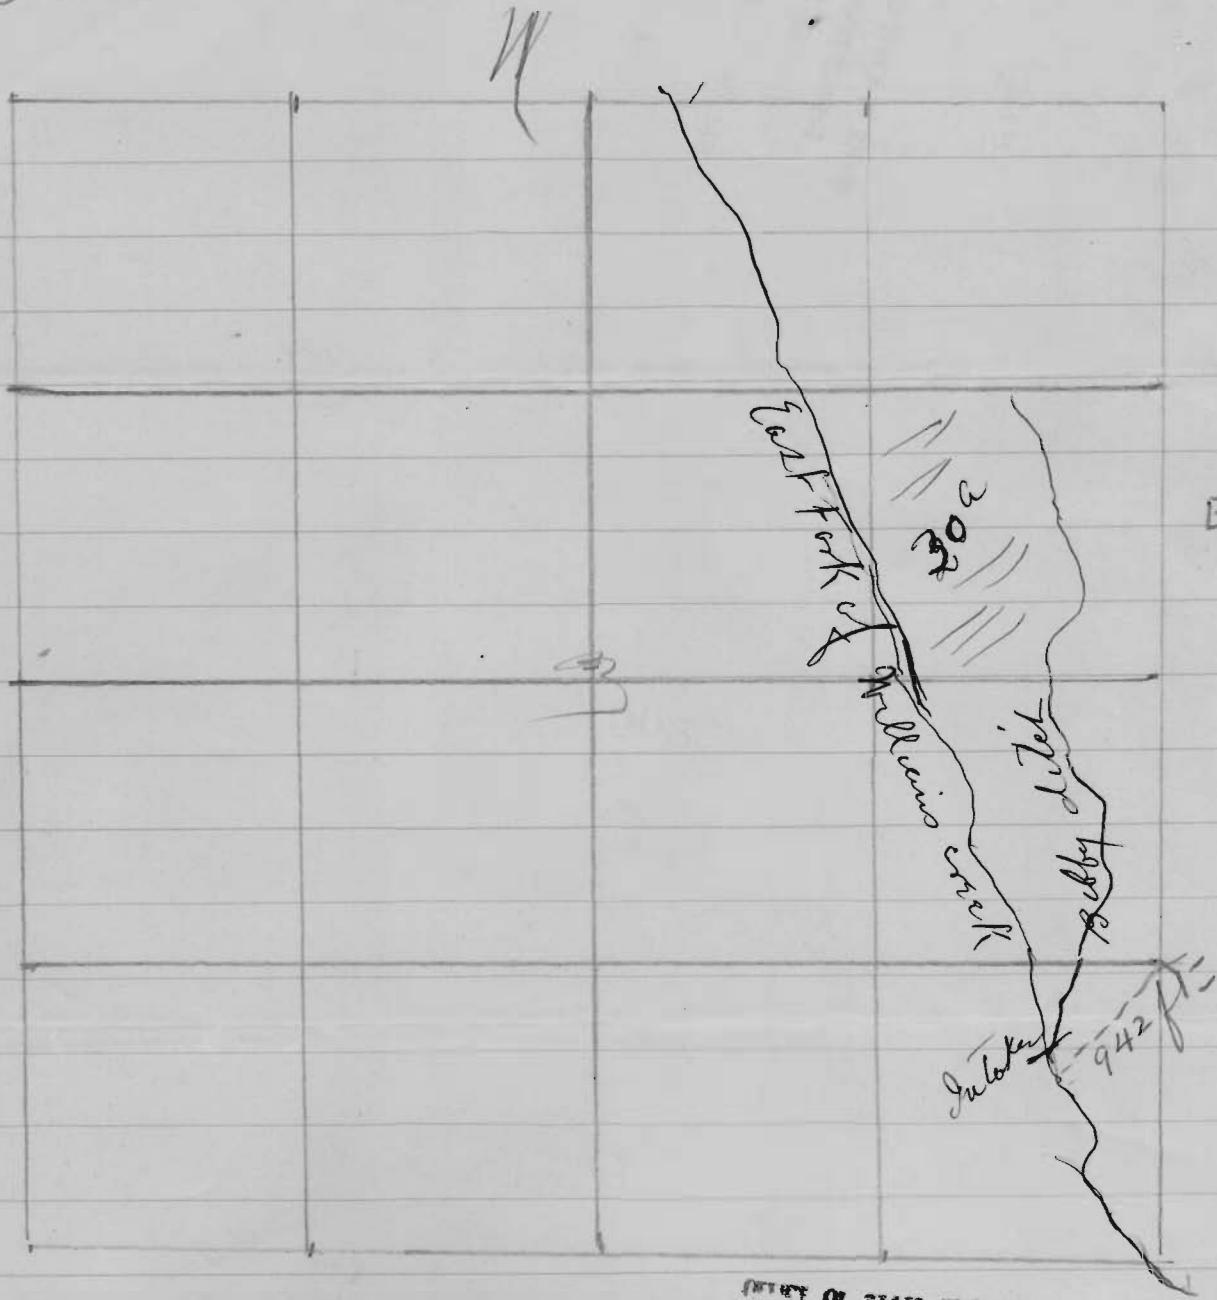

scale 6 inches = 1 mile

OFFICE OF STATE ENGINEER  
RECEIVED  
JUL 7 1916  
SAI. P.M. . . . OREGON

Application No. 5022  
Permit No. 3001