


T.7S. R.6W.W.M.

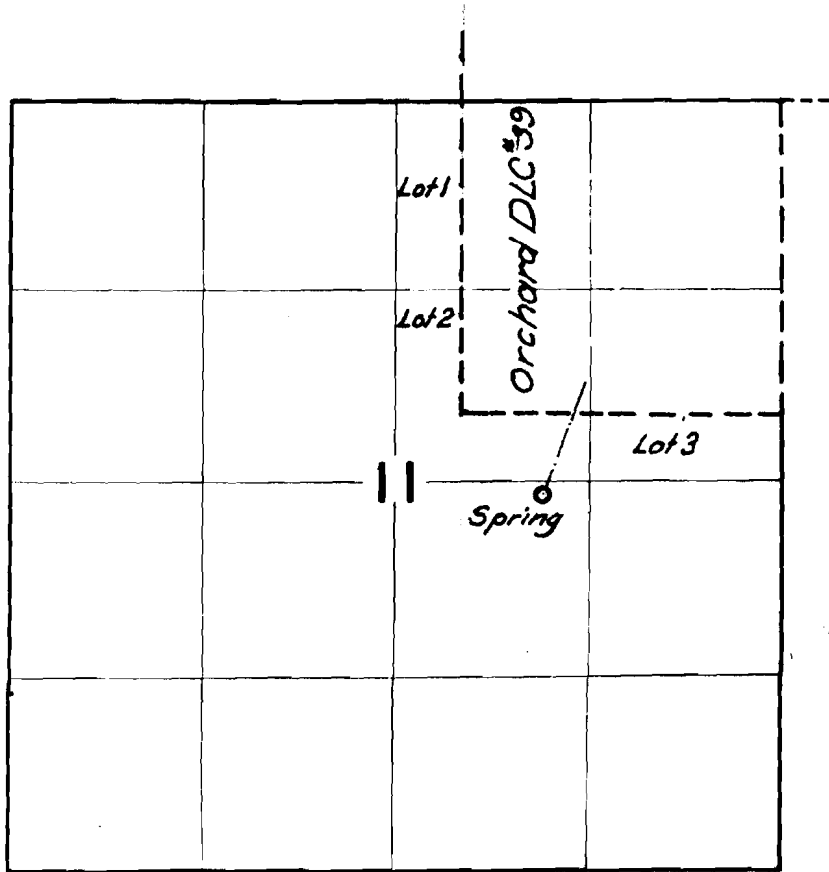

FINAL PROOF SURVEY
UNDER

Transfer B-115


Application No. *40280* Permit No. *30031*

IN NAME OF

Harry E. Brown

Surveyed *27 Aug.* 1962, by *Carl R. Baker*

TOWNSHIP 7 S., RANGE 6 W.

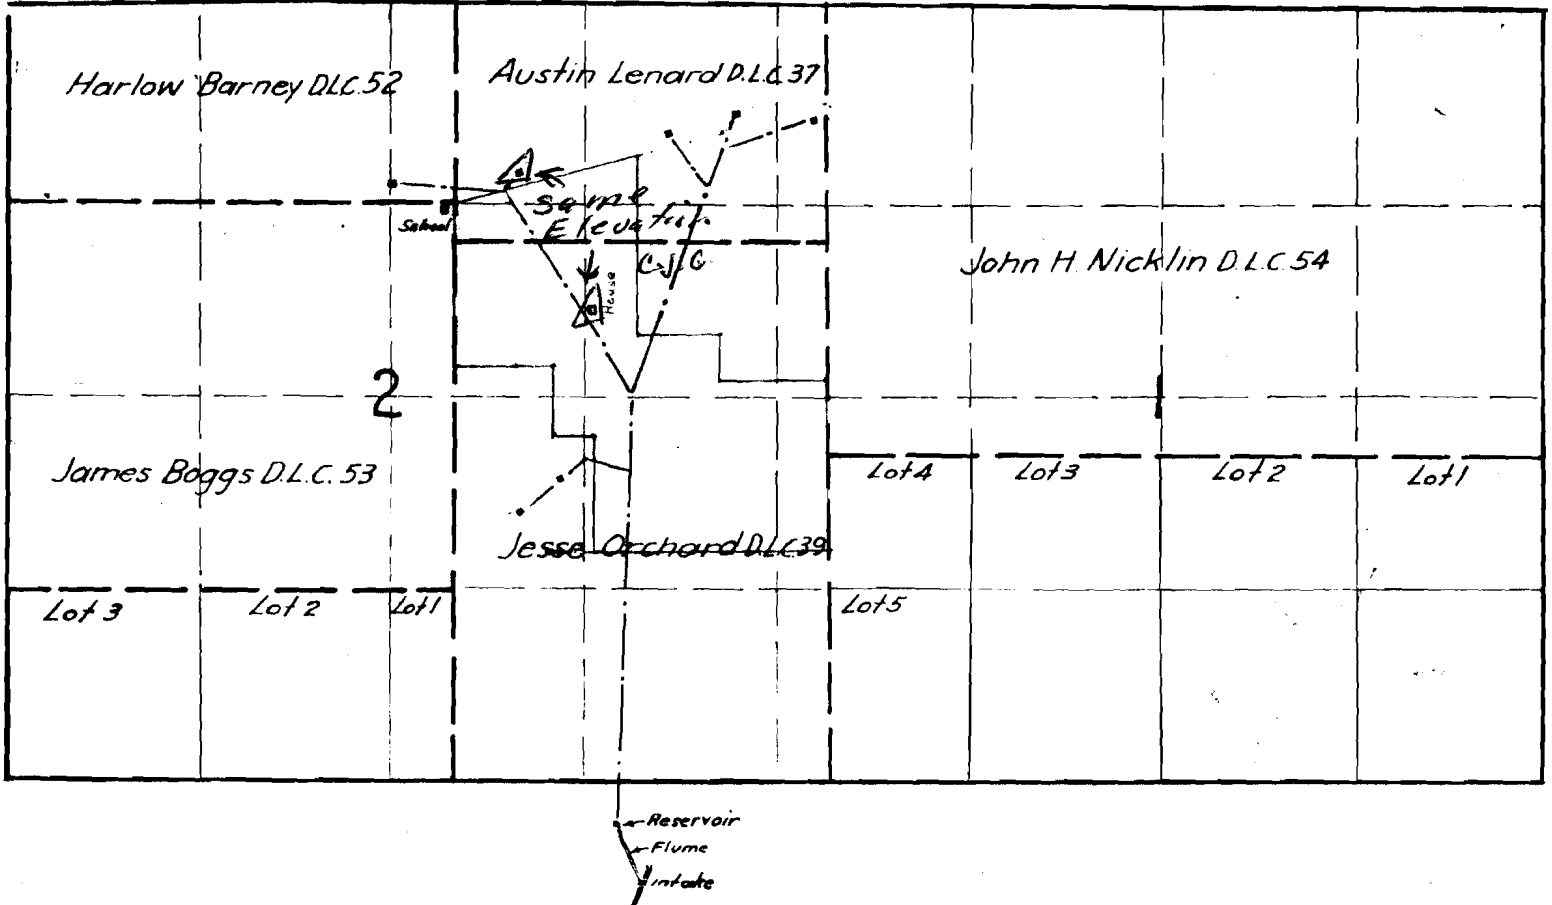

Application No. 40286
Permit No. 30031

FINAL PROOF SURVEY
UNDER

Application No. 18951 Permit No. 14553

IN NAME OF

Jessie I. Bennett

Surveyed May 13, 1941, by *C. L. Cummings*