


— MAP —

— Accompanying application of ANSIL GILSON and R. S. BULLIS
for permit to appropriate the waters of Sterling Creek
tributary to Rogue River. Jackson County, Oregon. —

— July 12th 1916 —
— Medford. Oregon. —

Tp 39. S. R. 2. W. W. M.

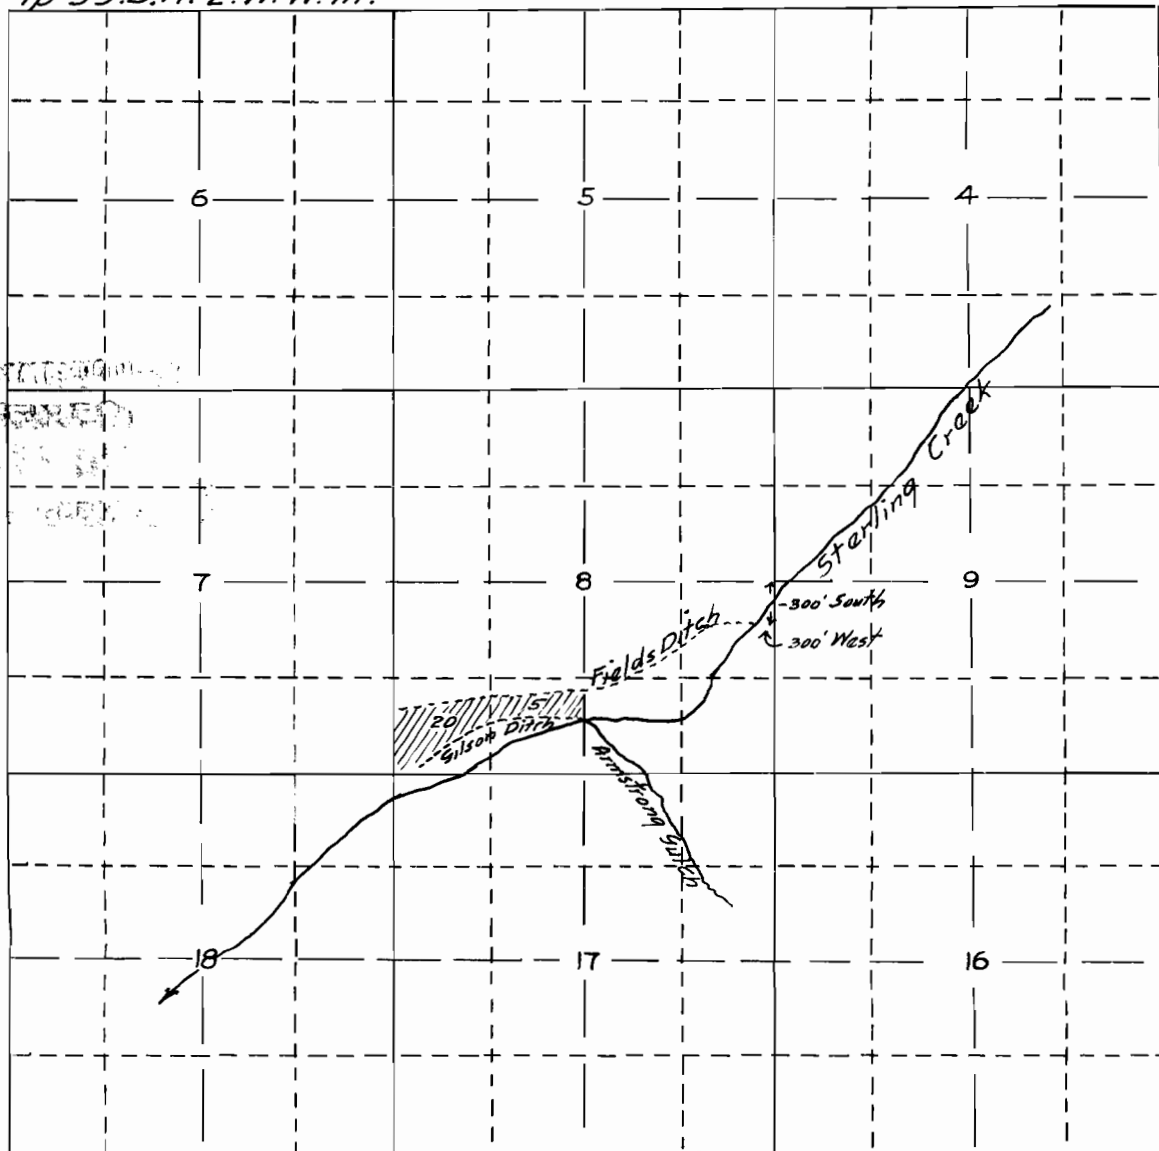

— Map made from notes and measurements of an actual
surrey by R. S. Bullis and plat compiled by. —

5054
3027

— Fred. N. Cummings. C.E. —
Medford. Oregon.