RECEIVED
MAR 12 1965
STATE ENGINEER
SALEM OREGON

This map prepared from survey map by Richard R. Ecker and from information furnished by Applicant.

Application No. 40676
Permit No. 30300

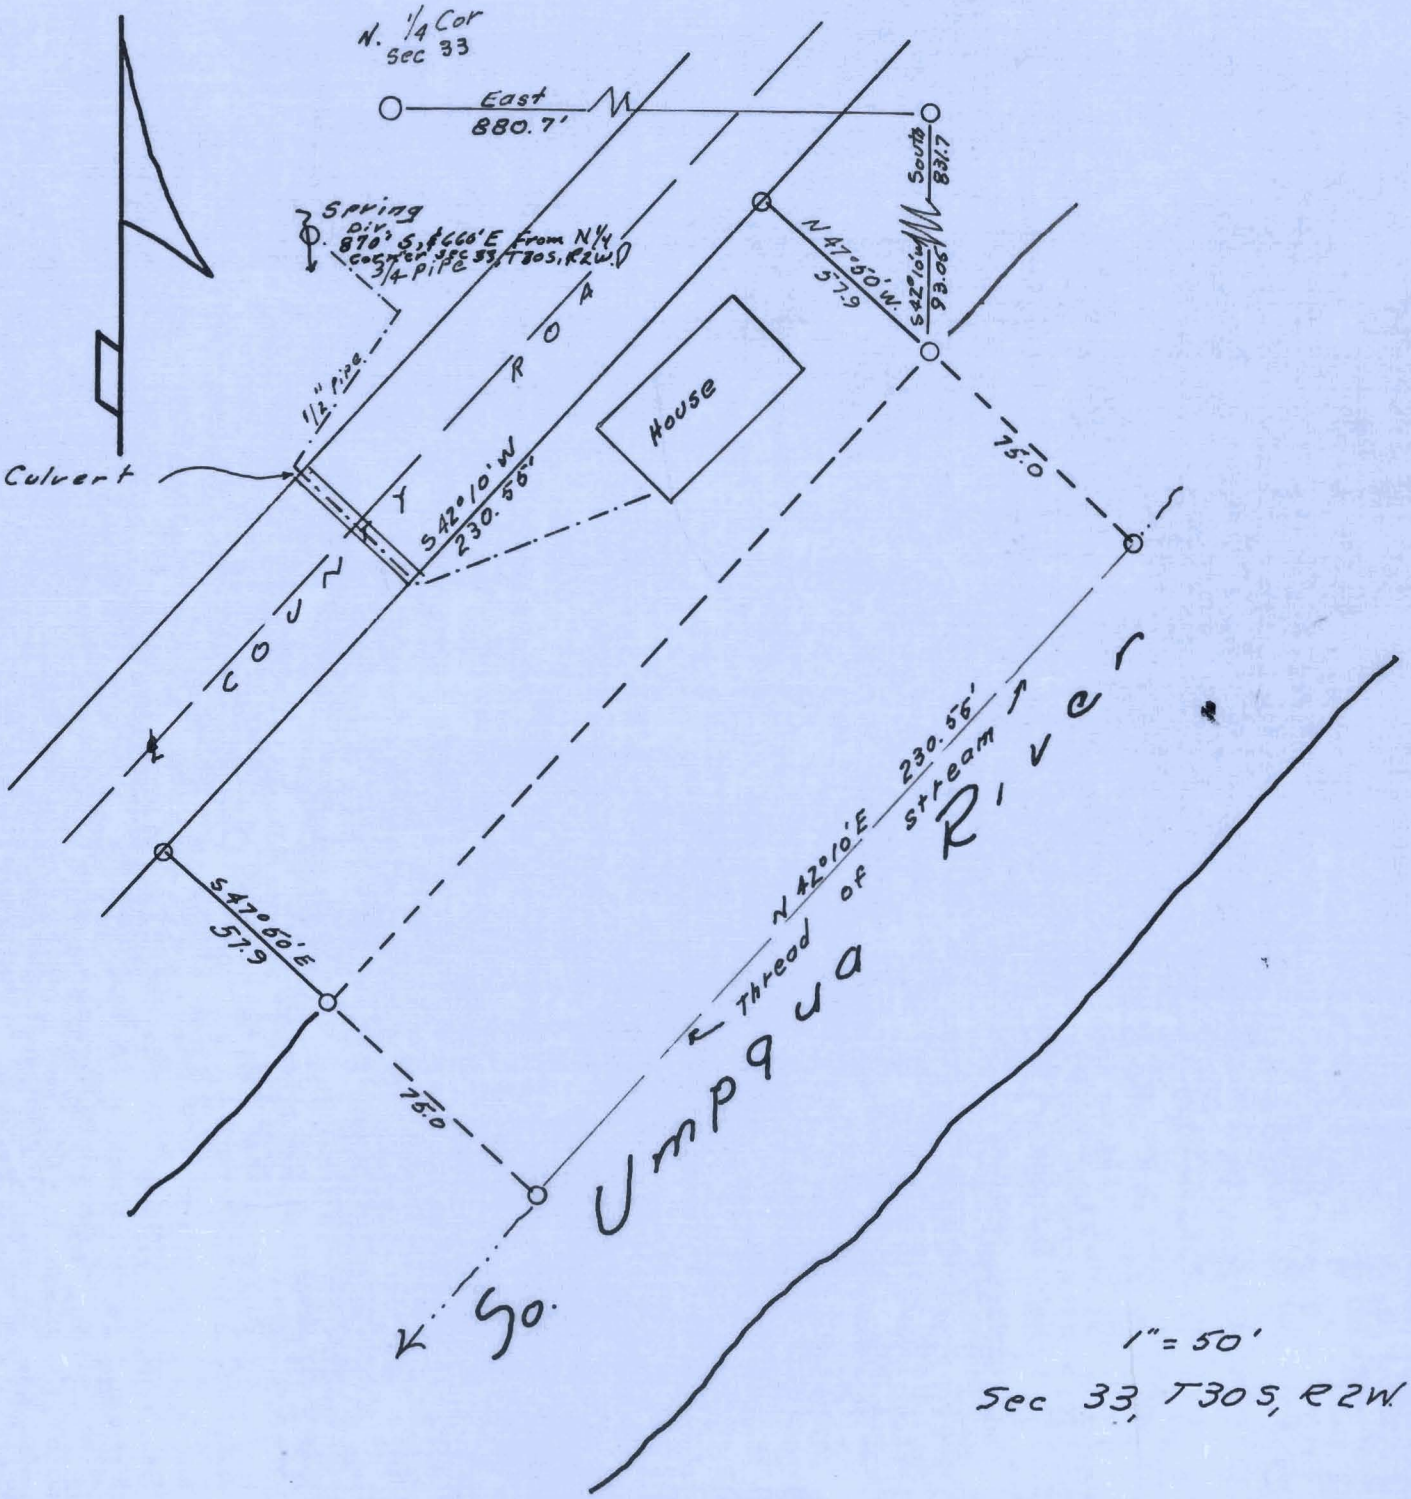

1" = 50'

Sec 33, T30S, R2W.