


PERMIT 30306

T. 33 S. R. 10 <sup>W</sup> E. W. M.

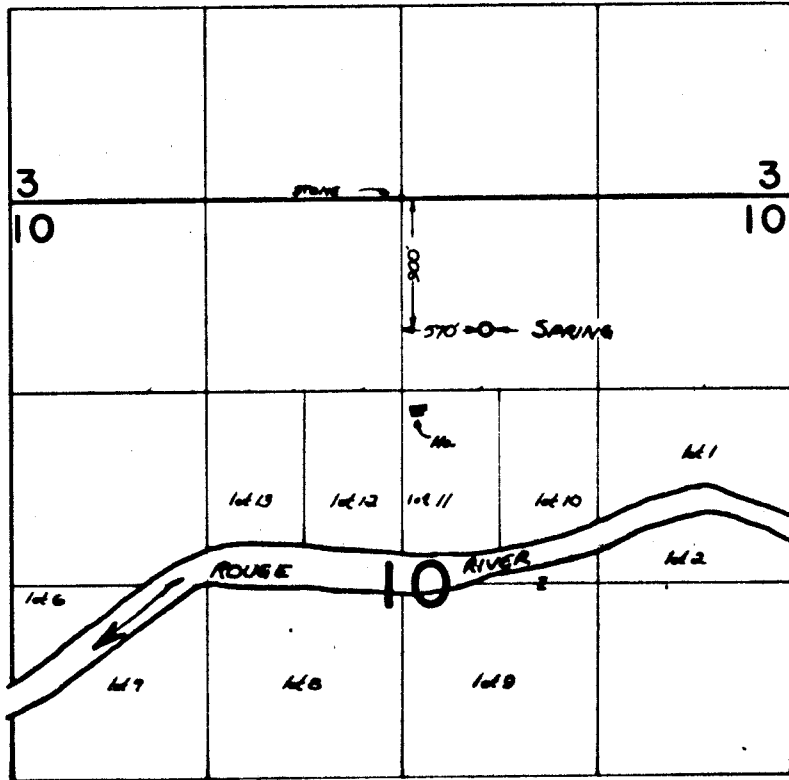

**FINAL PROOF SURVEY**  
UNDER

Application No. 40351... Permit No. 30306...  
IN NAME OF

**WILLIAM HENRY STEWART**

Surveyed 19 SEPT. 1969, by L. E. GOULD

LES 89 W