


RECEIVED
JUN 2 1965

STATE ENGINEER
SALEM, OREGON

SEC. 12 T. 255. R6W, 11M.

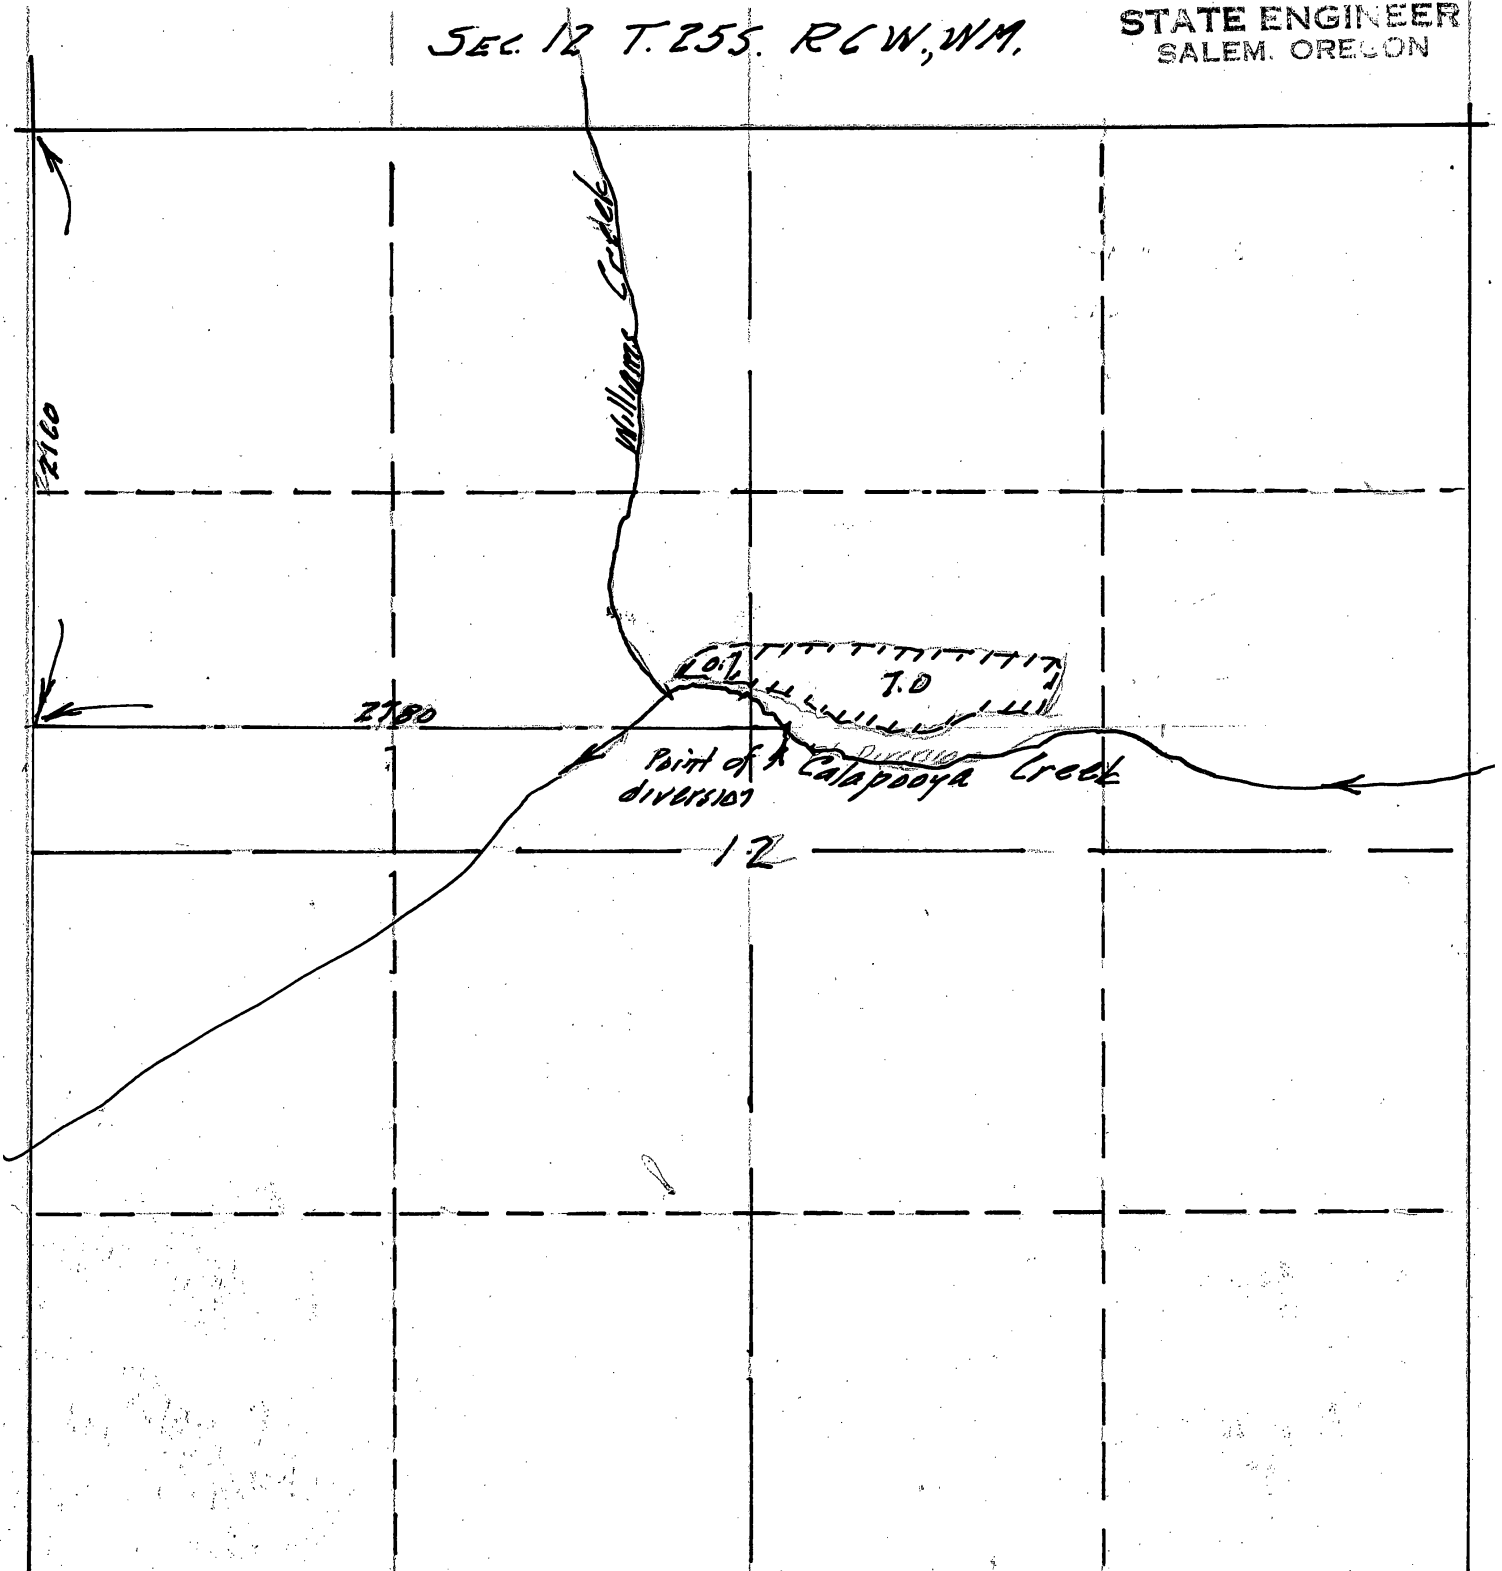

Application No. 40953
Permit No. 30430

scale 8" = 1 mi.

GEORGE A. TRUMBO
Water Right.