


Permit: S 30459
 Volume: 8A
 G Strm: UNN STR>GRANNYS RUN
 Trib: W FK ILLINOIS R
 Priority: 5/10/65

T.40S., R.8 & 9W., W.M.

30459

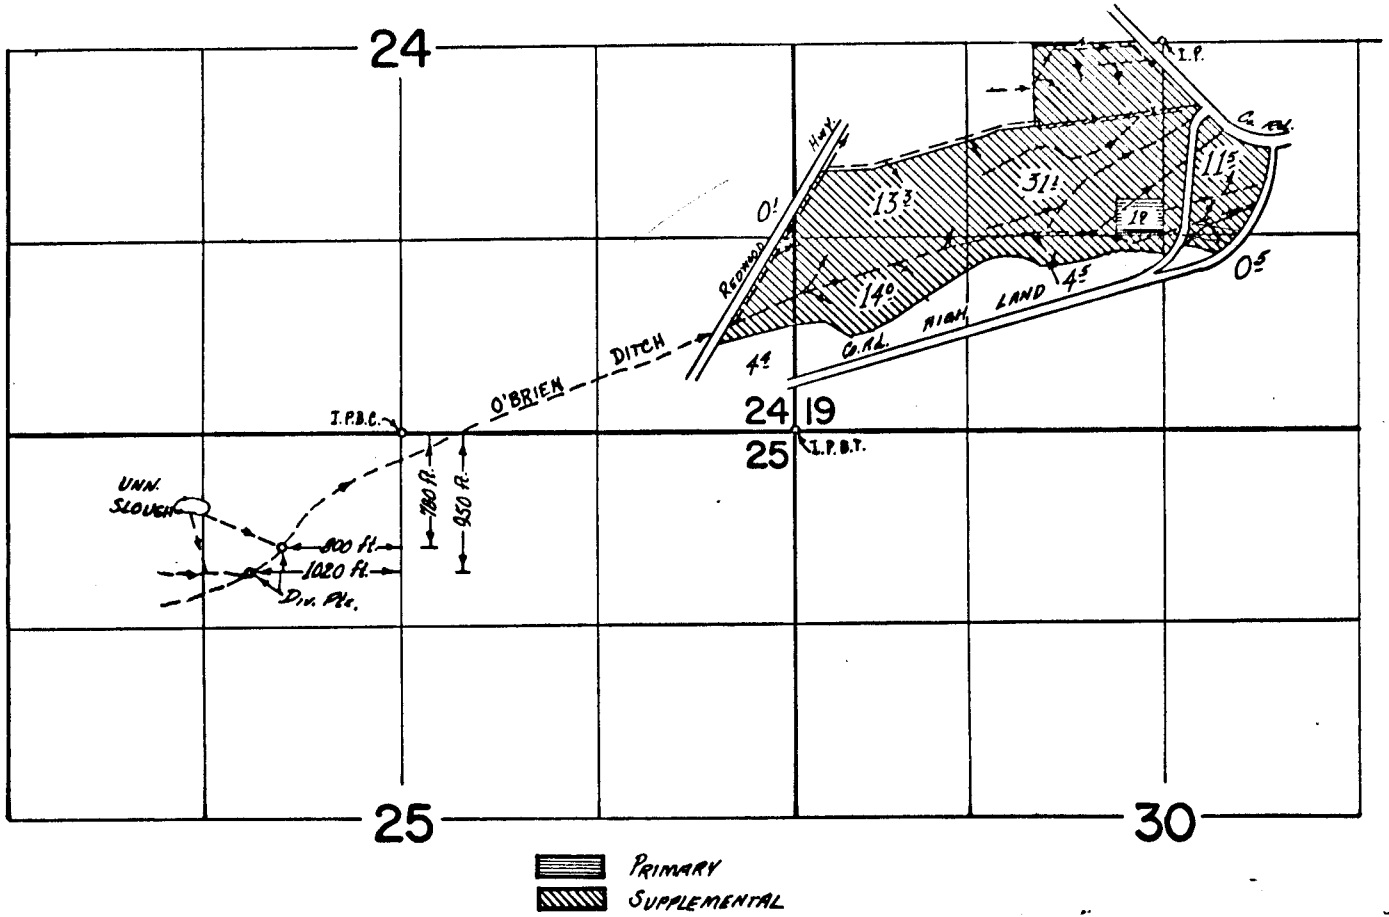

FINAL PROOF SURVEY
 UNDER

RECEIVED

JAN 29 1975

WM. DIST. 14
 GRANTS PASS. ORE.

Application No. 40860 Permit No. 30459
 IN NAME OF

LOYD LEWIS

Surveyed 2 Nov. 1972, by L.E. GOULD