


CANCELLED 3049
Transfer #
3049 RECEIVED
AUG 23 1979
CANCELLED
GRANTS PASS, ORE

T. 36 S., R. 1 W., W.M.
Jackson County

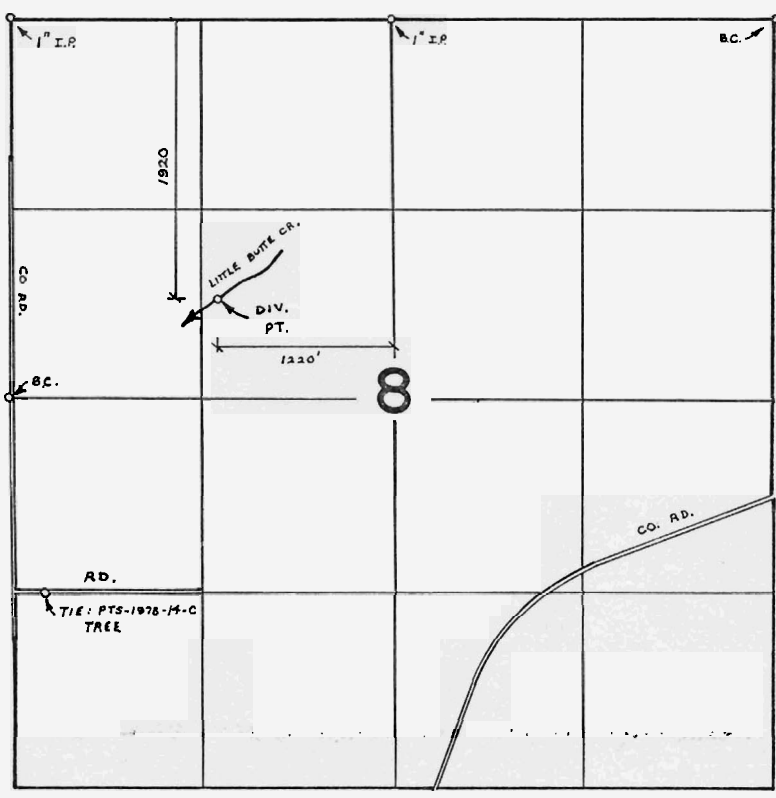

36-1W-8

FINAL PROOF SURVEY
UNDER

Application No. TR-3049 Permit No. _____
IN NAME OF
TIMOTHEUS J. HORN
Surveyed AUG. 22 1978, by B. SUND

CANCELLED