


SURVEY MAP FOR WATER RIGHTS FOR SYDNEY T. ROBERTS

ON A SPRING FOR DOMESTIC PURPOSES
IN LOT 7 OF CARLSON HEIGHTS SEC.12 T25S R13WWM

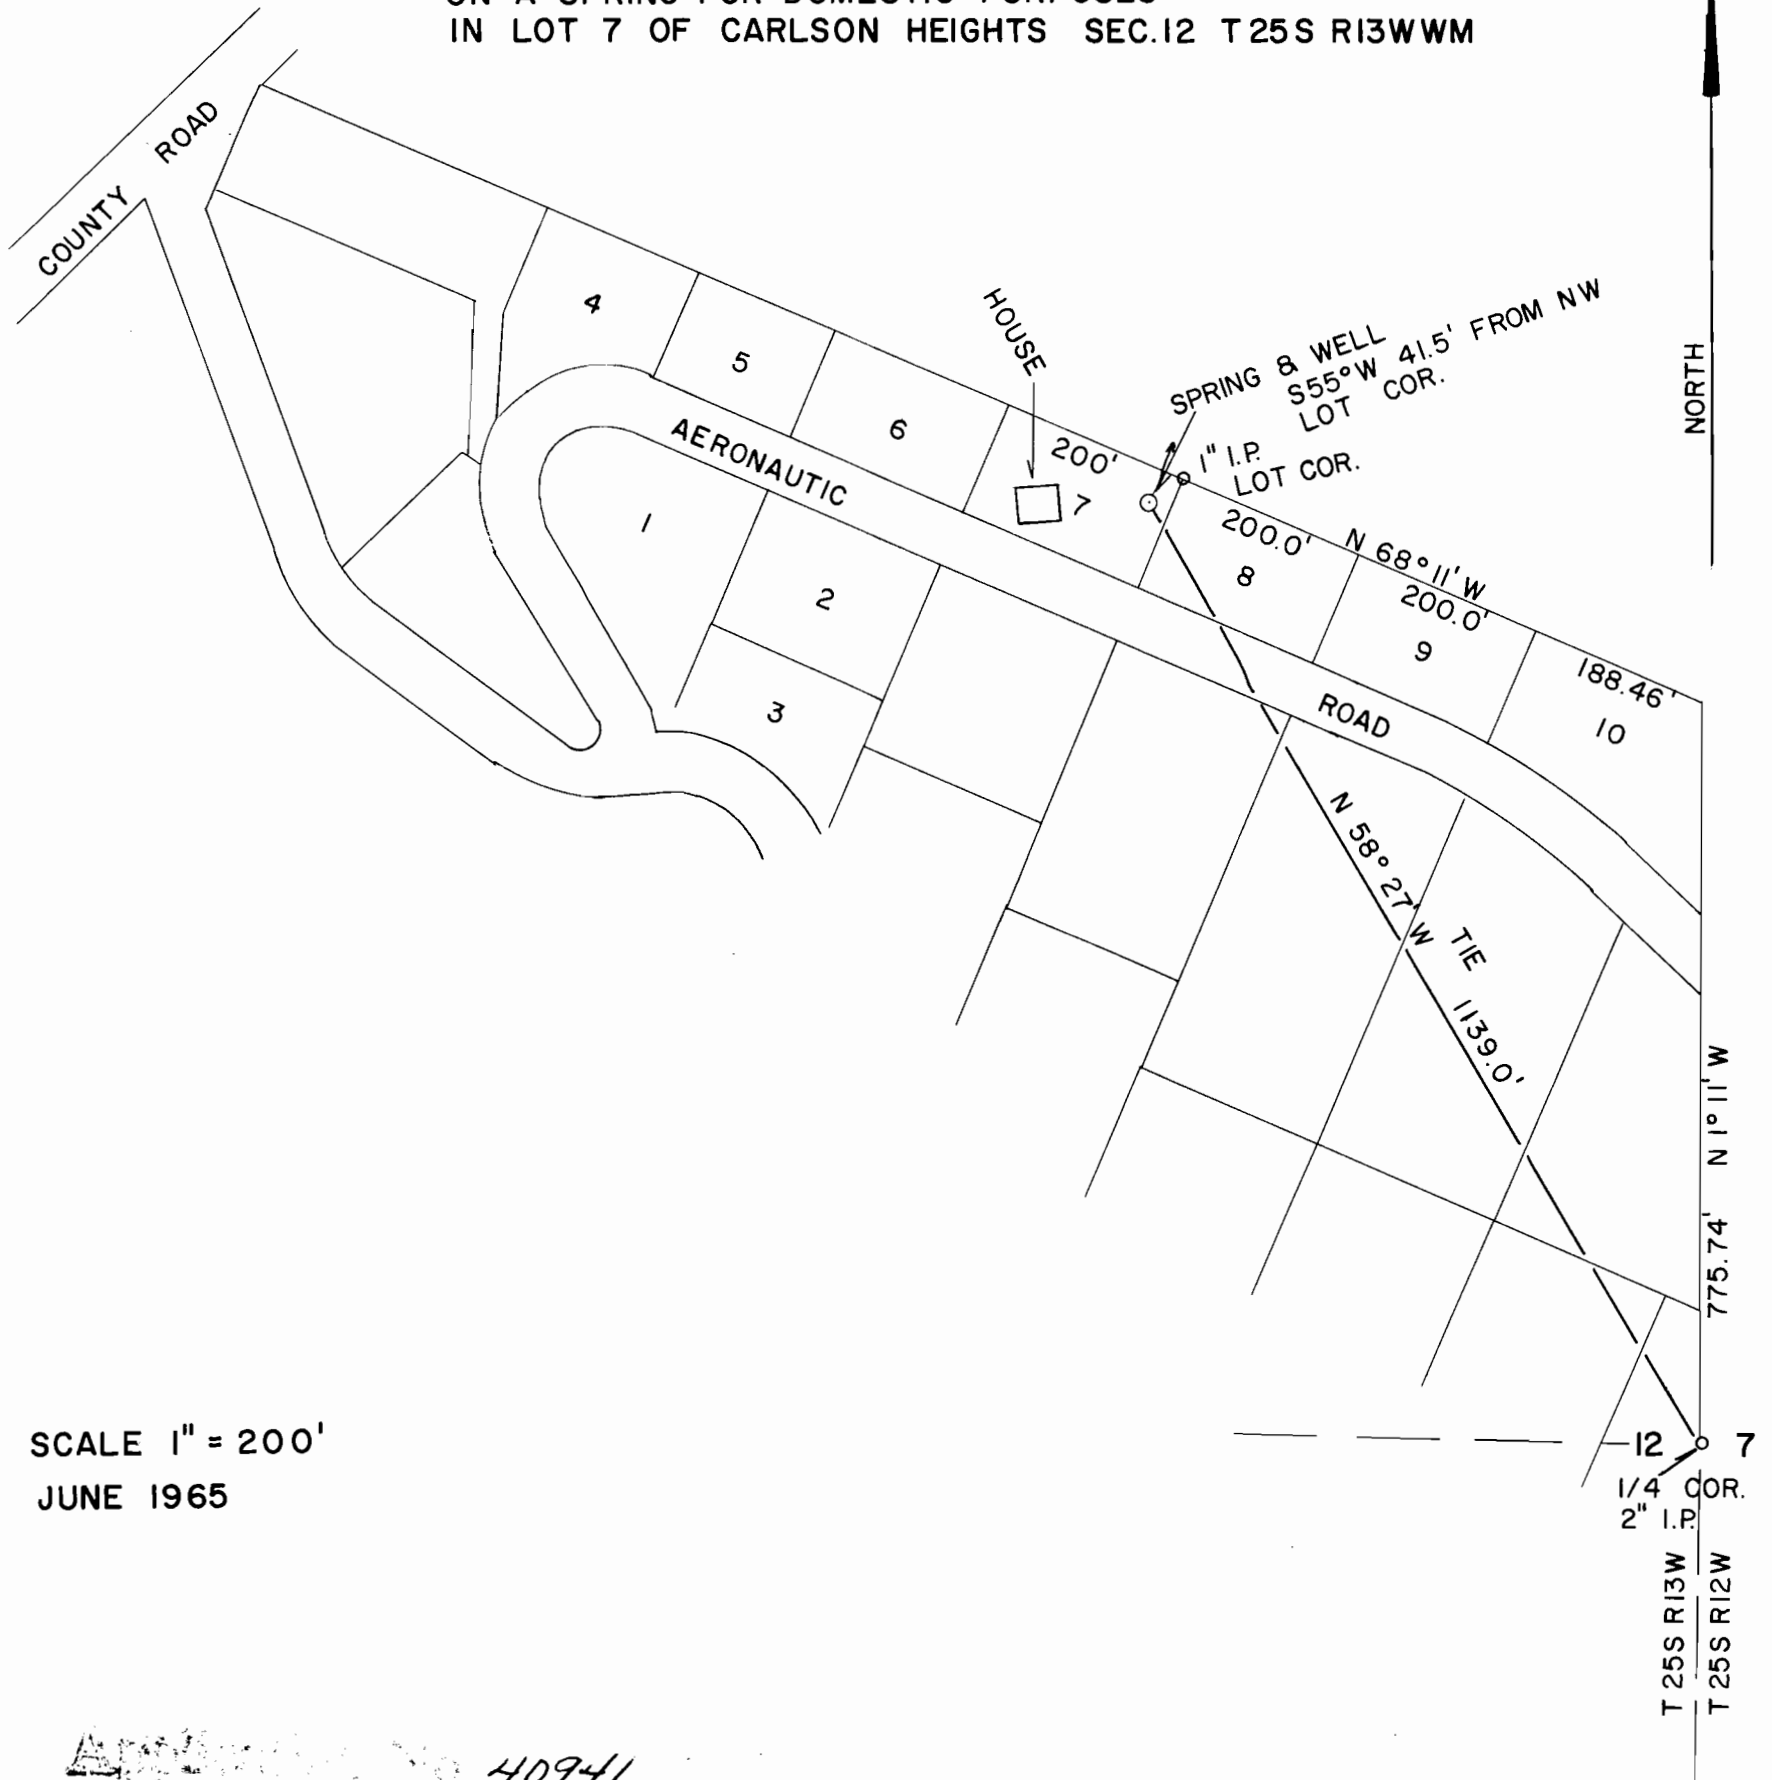

SCALE 1" = 200'
JUNE 1965

Applicant No. 40941
Permit No. 30540

REGISTERED
OREGON
LAND SURVEYOR

Ronald L. Durham

JULY 12, 1963
RONALD L. DURHAM
606

F.L.L.

LEWD CONSULTANTS & SURVEYORS
1.12 W 65