


# T. 3 S. R. 3 W. W. M.

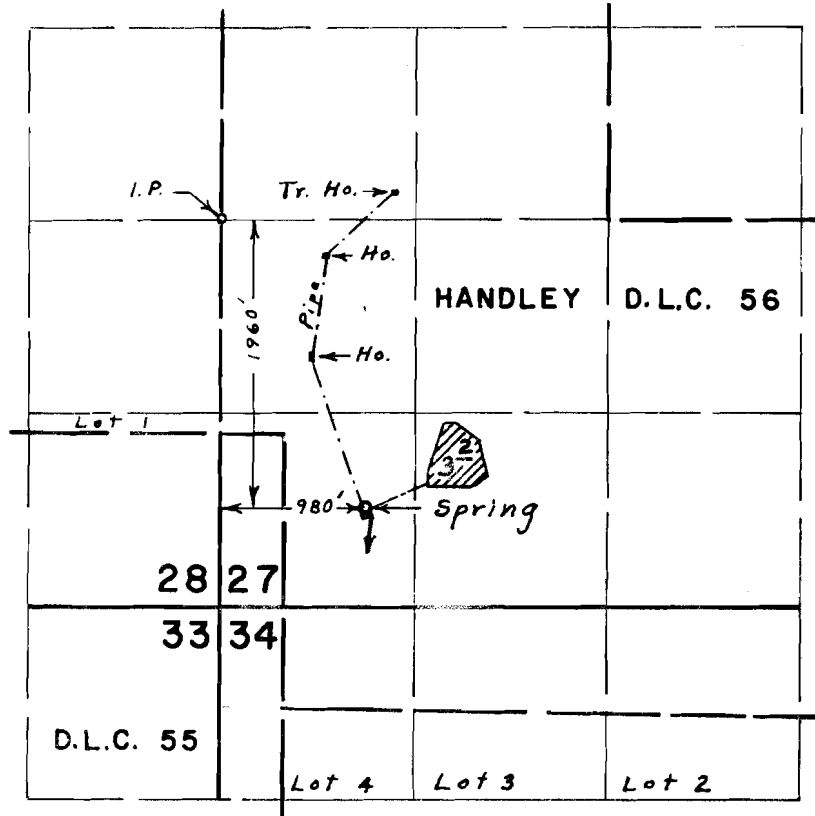

## FINAL PROOF SURVEY UNDER

Application No. 40958      30546  
44018      Permit No. 32902  
 IN NAME OF

**JAMES A. MARESH**

Surveyed Aug. 20, 1971, by L. E. Gould