


# OAK GROVE PARK

SECTIONS 20, 21, T27 S., R4 W., W.M.

DOUGLAS COUNTY, OREGON  
BEN. B. IRVING REG. CIVIL ENGINEER.  
ROSEBURG, OREGON.

SCALE 1"=100'

Note:-  
The 5' Strips of land shown, lying alongside of Lot lines,  
are for Easements for Water Pipe Lines to the Lots lying at  
the Northerly end of said strips, from Deer Creek.

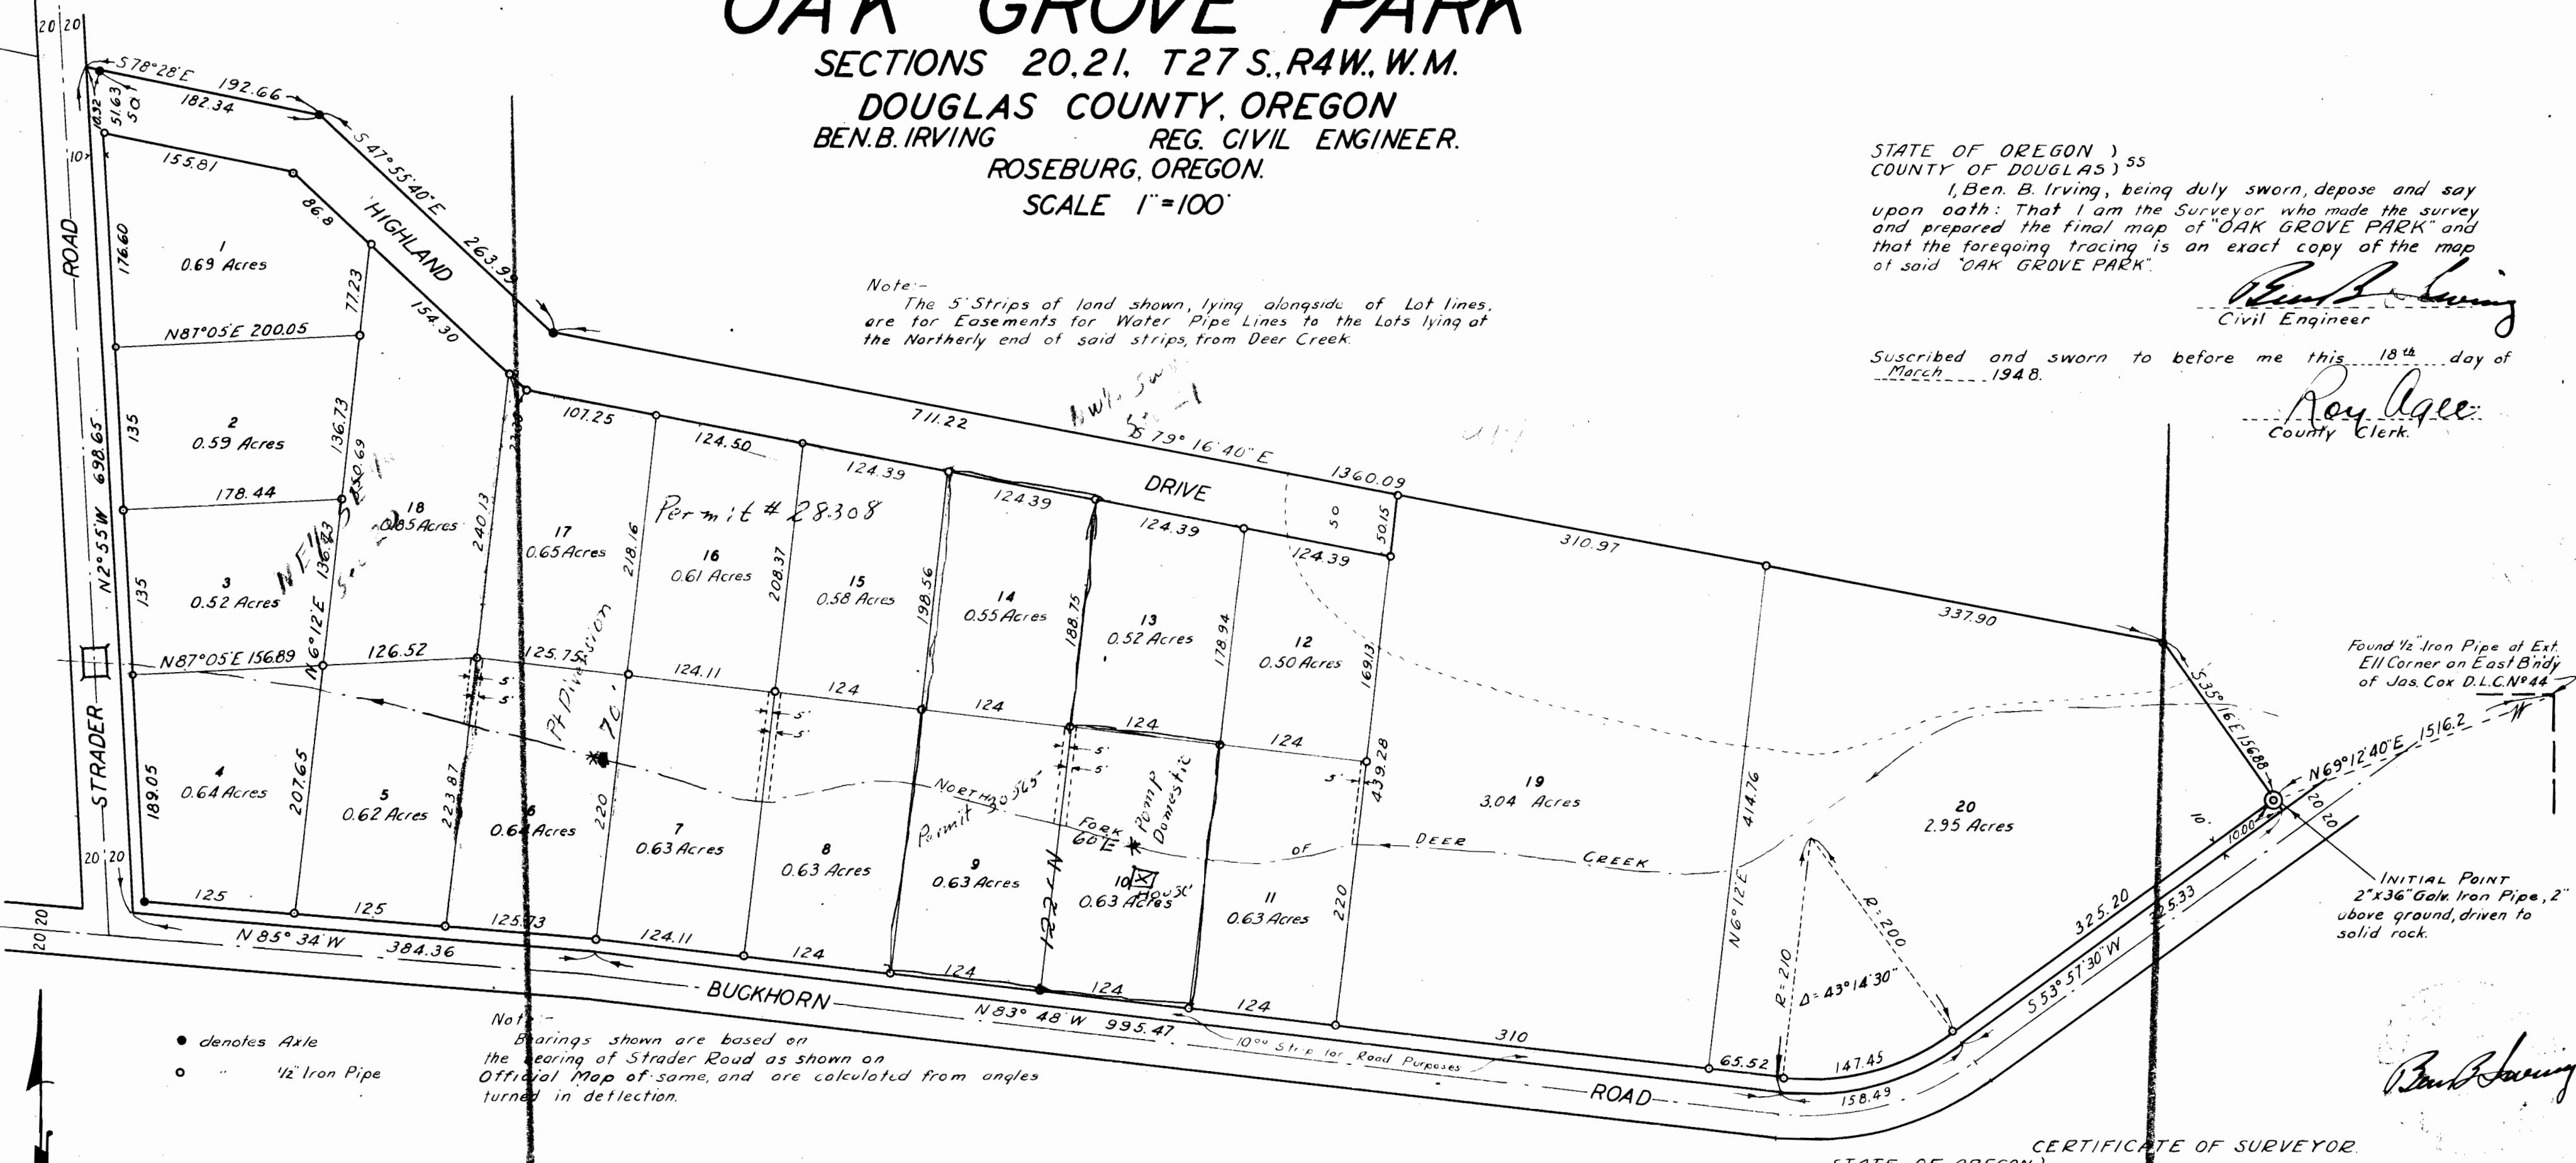

- denotes Axle
- " 1/2" Iron Pipe

## DEDICATION

KNOW ALL MEN BY THESE PRESENTS that WE, G.A. Lindblom and Hattie C. Lindblom, Husband and Wife, owners of the lands represented and described on the annexed plat, have caused the same to be surveyed and platted by the name of "OAK GROVE PARK", and we hereby dedicate to the use of the public forever, the road shown thereon.

IN TESTIMONY WHEREOF, the said G.A. Lindblom and Hattie C. Lindblom have hereunto set their hands, this 18<sup>th</sup> day of March 1948.

*G.A. Lindblom*  
G.A. Lindblom  
*Hattie C. Lindblom*

Hattie C. Lindblom

APPROVED March 19 1948

*D.W. Busenbach*  
COUNTY JUDGE

APPROVED 19 March 1948

*Ned Dixon*  
COUNTY ASSESSOR

## ACKNOWLEDGEMENT

STATE OF OREGON 1948  
COUNTY OF DOUGLAS

On the 18<sup>th</sup> day of March 1948, before me appeared G.A. Lindblom and Hattie C. Lindblom, to me personally known, who being duly sworn, did say that they are the lawful owners of the tract of land delineated on the annexed plat, and that they do hereby acknowledge that they signed the accompanying dedication as their free and voluntary act and deed.

IN TESTIMONY WHEREOF, I have hereunto set my hand and affixed my official seal this day and year above written.

*Roy Agree*  
ROY AGREE  
COUNTY CLERK

## CERTIFICATE OF SURVEYOR

STATE OF OREGON 1948  
COUNTY OF DOUGLAS

I, Ben B. Irving, being first duly sworn, depose and say that I have correctly surveyed and marked with proper monuments the lands delineated on the annexed plat, of which the following is a true and correct description: Beginning at a 2"x36" Galv. Iron Pipe, 2" above ground, and driven to solid rock, from which pipe the Exterior Ell Corner on the East boundary of the Jas. Cox D.L.C.N#44, T27S, R4W, W.M. bears N69°12'40"E 1516 2'; Thence S 35°16'E 10 22' to a point on the North boundary of Buckhorn Road; Thence following said boundary S 53°57'30"W 325 22 ft. to the beginning of a curve to the right, having a radius of 210 ft. and a central angle of 43°14'30"; Thence along said curve 158 49 ft. to the end thereof; Thence N83°48'W 995 47 ft. and N85°34'W 384 36 ft. to the intersection of said North boundary with the East boundary of Strader Road; Thence N2°55'W 698 65 ft. along said East boundary; Thence S 78°28'E 10 22' to an axle, and 182 24 ft. to an axle; Thence S 47°55'40"E 203 29 ft. to an axle; Thence S 79°16'40"E 711 22 ft. to a 1/2" I.P., and 310 27 ft. to a 1/2" I.P., and 337 22 ft. to a 1/2" I.P.; Thence S 35°16'E 156 22 ft. to the point of beginning: containing 21 1/8 Acres, more or less in Sections 20, and 21, T27S, R4W, W.M., Douglas County, Oregon.

Oregon No 240.  
November 8, 1948.

*Ben B. Irving*  
Ben B. Irving  
Registered Professional Engineer

Suscribed and sworn to before me this 18<sup>th</sup> day of March 1948.

Application No. 40998  
Permit No. 30565

RECEIVED FILED  
JUN 10 1965  
STATE ENGINEER  
SALEM, OREGON

March 19<sup>th</sup> 1948  
*Roy Agree*  
ROY AGREE  
COUNTY CLERK