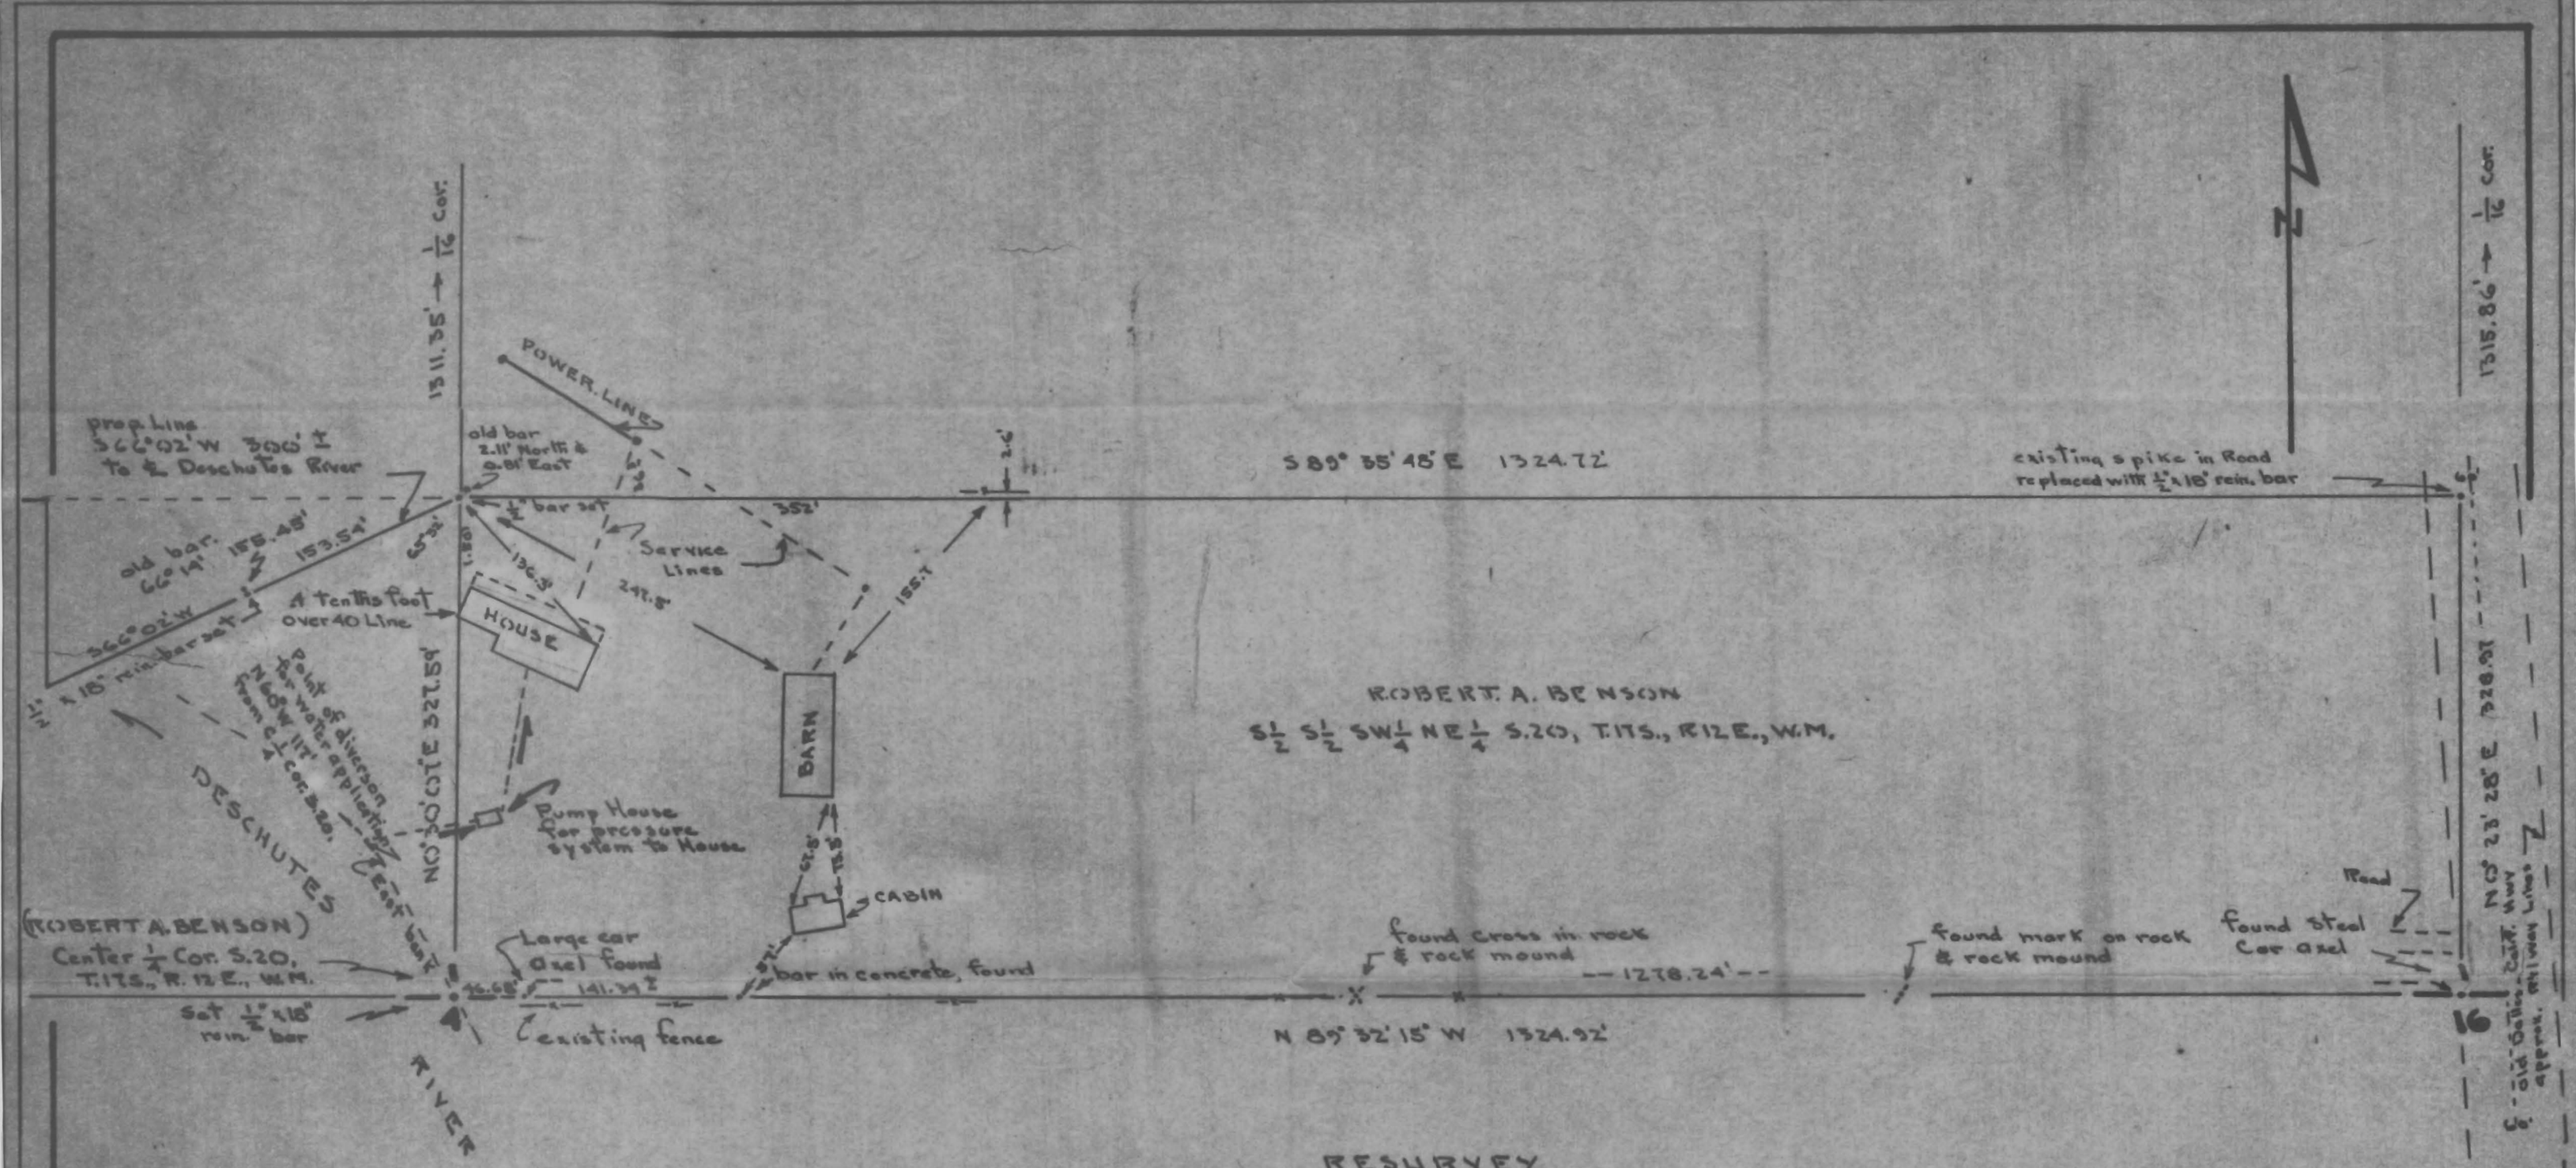

ROBERT A. BENSON

S½ S½ SW¼ NE¼ S.20, T.17S., R.12E., W.M.

SCALE 1"=100'

RESURVEY
OF
S½ S½ SW¼ NE¼ S. 20, T.17S., R.12E., W.M.
FOR

ROBERT A BENSON

RT. 2, Box 14
Bend —— Oregon

Sept. 13. 1965

by Jean Wm Hawthorne.

I, Jean Wm Hawthorne, Registered Oregon Land Surveyor #454, do hereby certify that I made the above resurvey of S½ S½ SW¼ NE¼ S.20, T.17S., R.12E., W.M. and the location of the existing buildings thereon & location of point of diversion for water use permit from the Deschutes River thru the State Engineers office.
Existing corner bars at NW Cor. do not correspond with this resurvey as shown above.
No encroachments were found; except the S.W. Corner of the above shown house does extend over the 40 Line 4 Tenths of a foot as indicated. Sept. 13, 1965. Jean Wm Hawthorne

Bearings are based on R.W. Gould's bearings for S.20., T.17S., R.12E., W.M.

REGISTERED
OREGON
LAND SURVEYOR
Jean Wm Hawthorne
OCTOBER 24, 1958
JEAN WM. HAWTHORNE
454

RECEIVED
SEP 17 1965
STATE ENGINEER
OREGON

Application No. 41213
Permit No. 30730