


T. 8 S. R. 1 W. W. M.

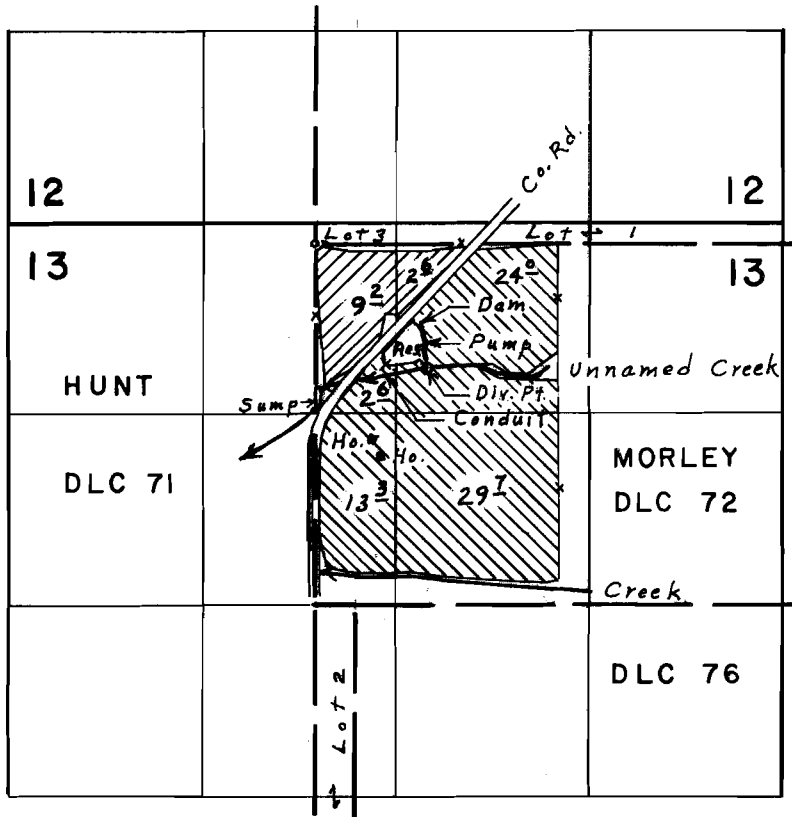

Div. Pts. located: Res. 680' S. & 750' E.; Unnamed Creek, 870' S. & 760' E.; Sump, 1080' S. & 20' E.; all from N.W. Cor. Morley D. L. C. 72

FINAL PROOF SURVEY
UNDER

R-41279 R-4644
Application No. 41280 Permit No. 30782
IN NAME OF

WALTER WINN

Surveyed July 6, 1973, by L. E. Gould