

- denotes Czhin
- denotes 3/4" pipe diversion
- denotes 4" pipe diversion

U  
 USES - WILLAMETTE  
 RECREATION  
 D  
 SUMMER HOME SITES  
 DETROIT RANGER DISTRICT




DRAFTER: J. J. ROBERTSON APPROVED: J. J. ROBERTSON DATE: 11/15/65 APPROVED: J. J. ROBERTSON	U.S. DEPARTMENT OF AGRICULTURE FOREST SERVICE WILLAMETTE NATIONAL FOREST THE PACIFIC NORTHWEST REGION	TRACT PLAN STAHLMAN CREEK SUMMER HOME SITES SECS 22, 23, 24, 25, T 10S, R 2E, W 1E SCALE 1" = 400' - (CONTOUR INTERVAL 20')
--	--	---

LEGEND

- Czhin
- 3/4" pipe diversion
- 4" pipe diversion

Application No. 41397  
 Permit No. 30922

**RECEIVED**  
 NOV 18 1965  
 STATE ENGINEER  
 SALEM OREGON

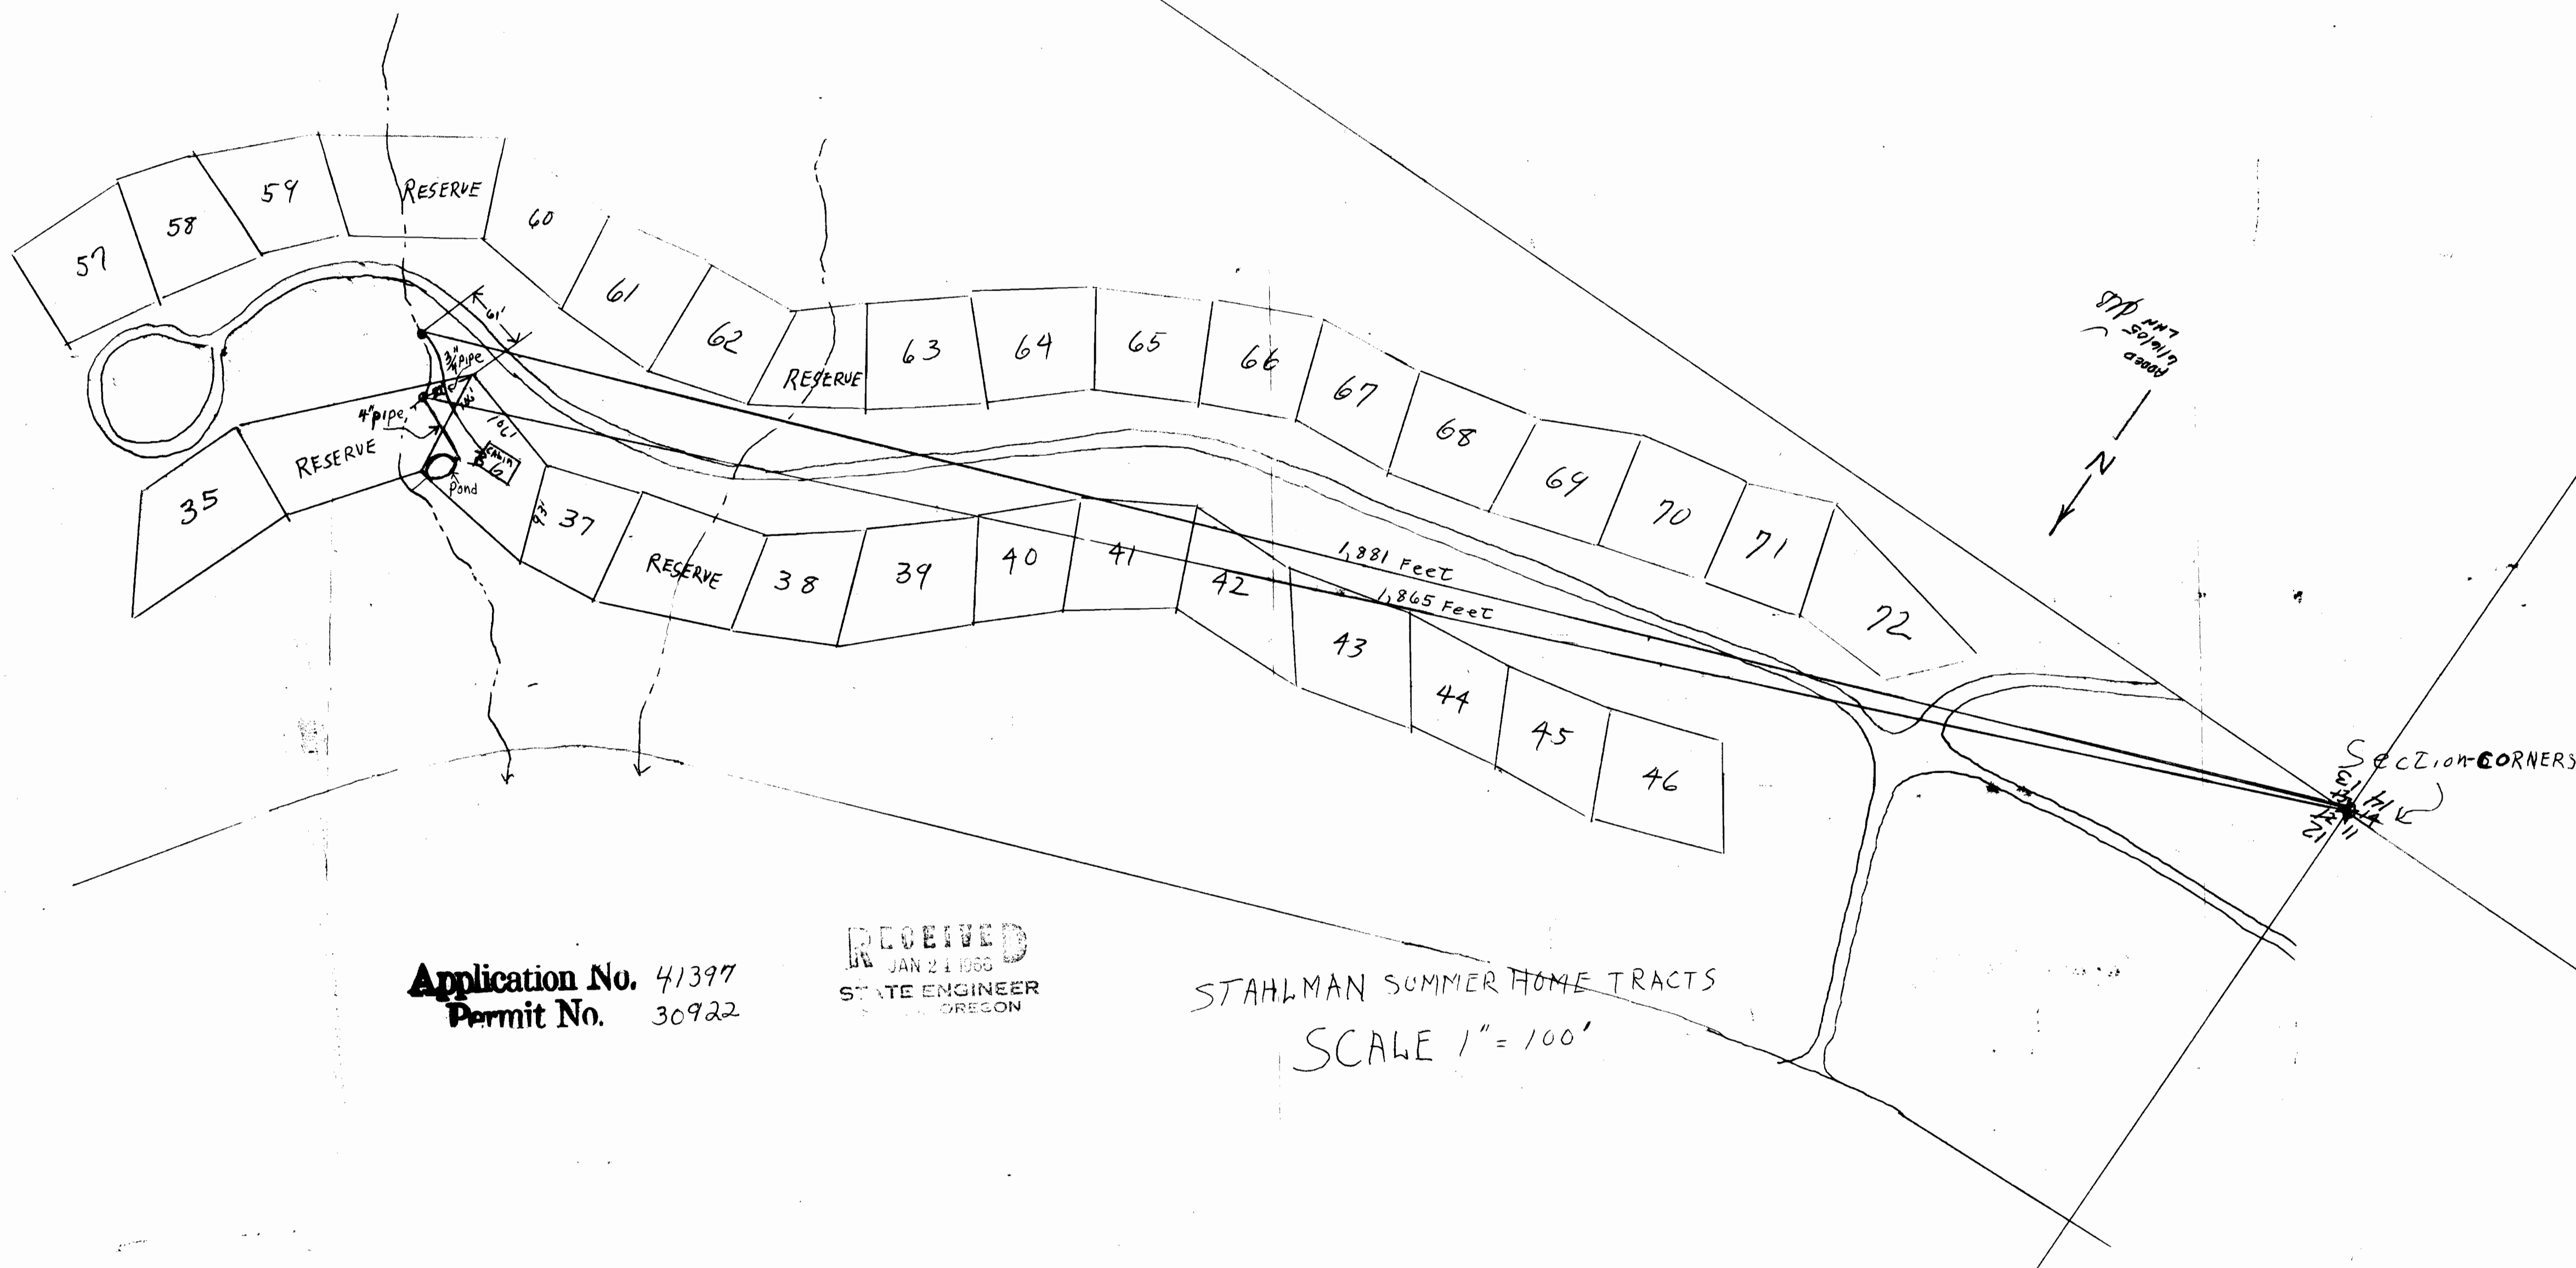


Application No. 41397  
 Permit No. 30922

RECEIVED  
 STATE ENGINEER  
 OREGON

STAHLMAN SUMMER HOME TRACTS  
 SCALE 1" = 100'

SECTION CORNERS  
 11  
 12

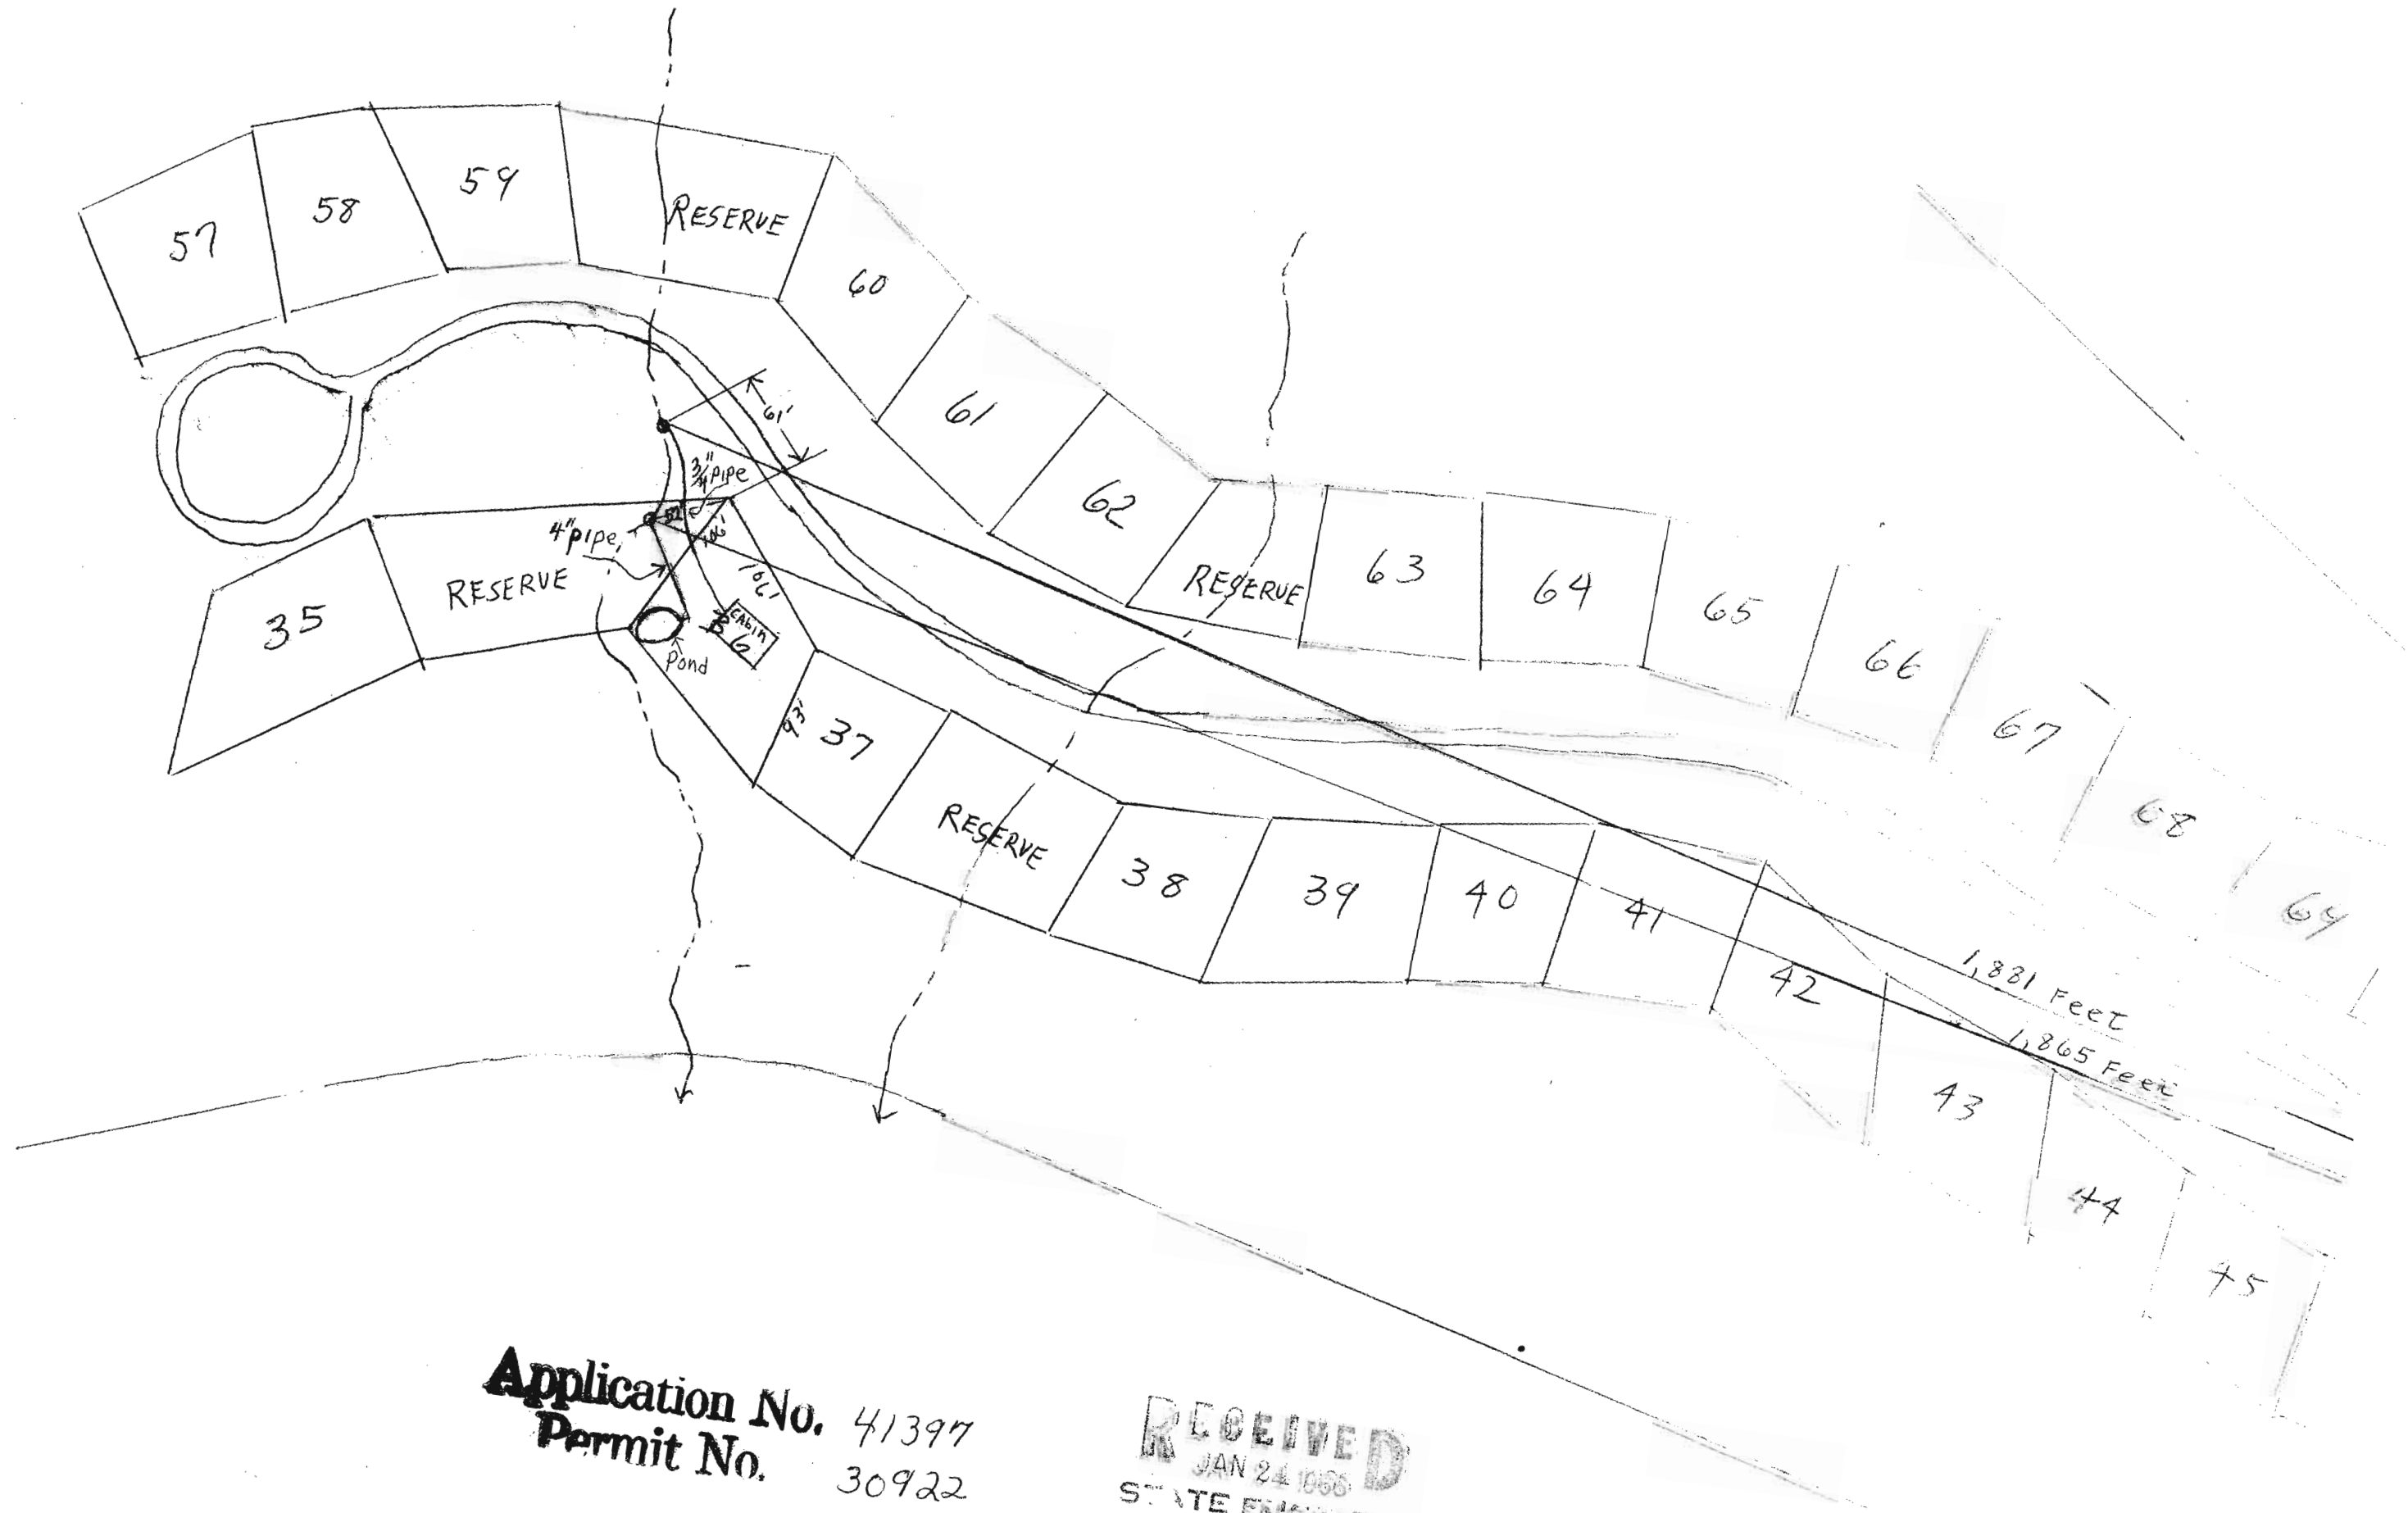

**Application No.** 41397  
**Permit No.** 30922

**RECEIVED**  
 JAN 24 1966  
 STATE ENGINEER  

STAHLMAN SUMMER HOME T  
 SCALE 1" = 100'