


# MARTIN

T 12 S, R 5 W, W. M., BE  
PRIER SCOTT D.

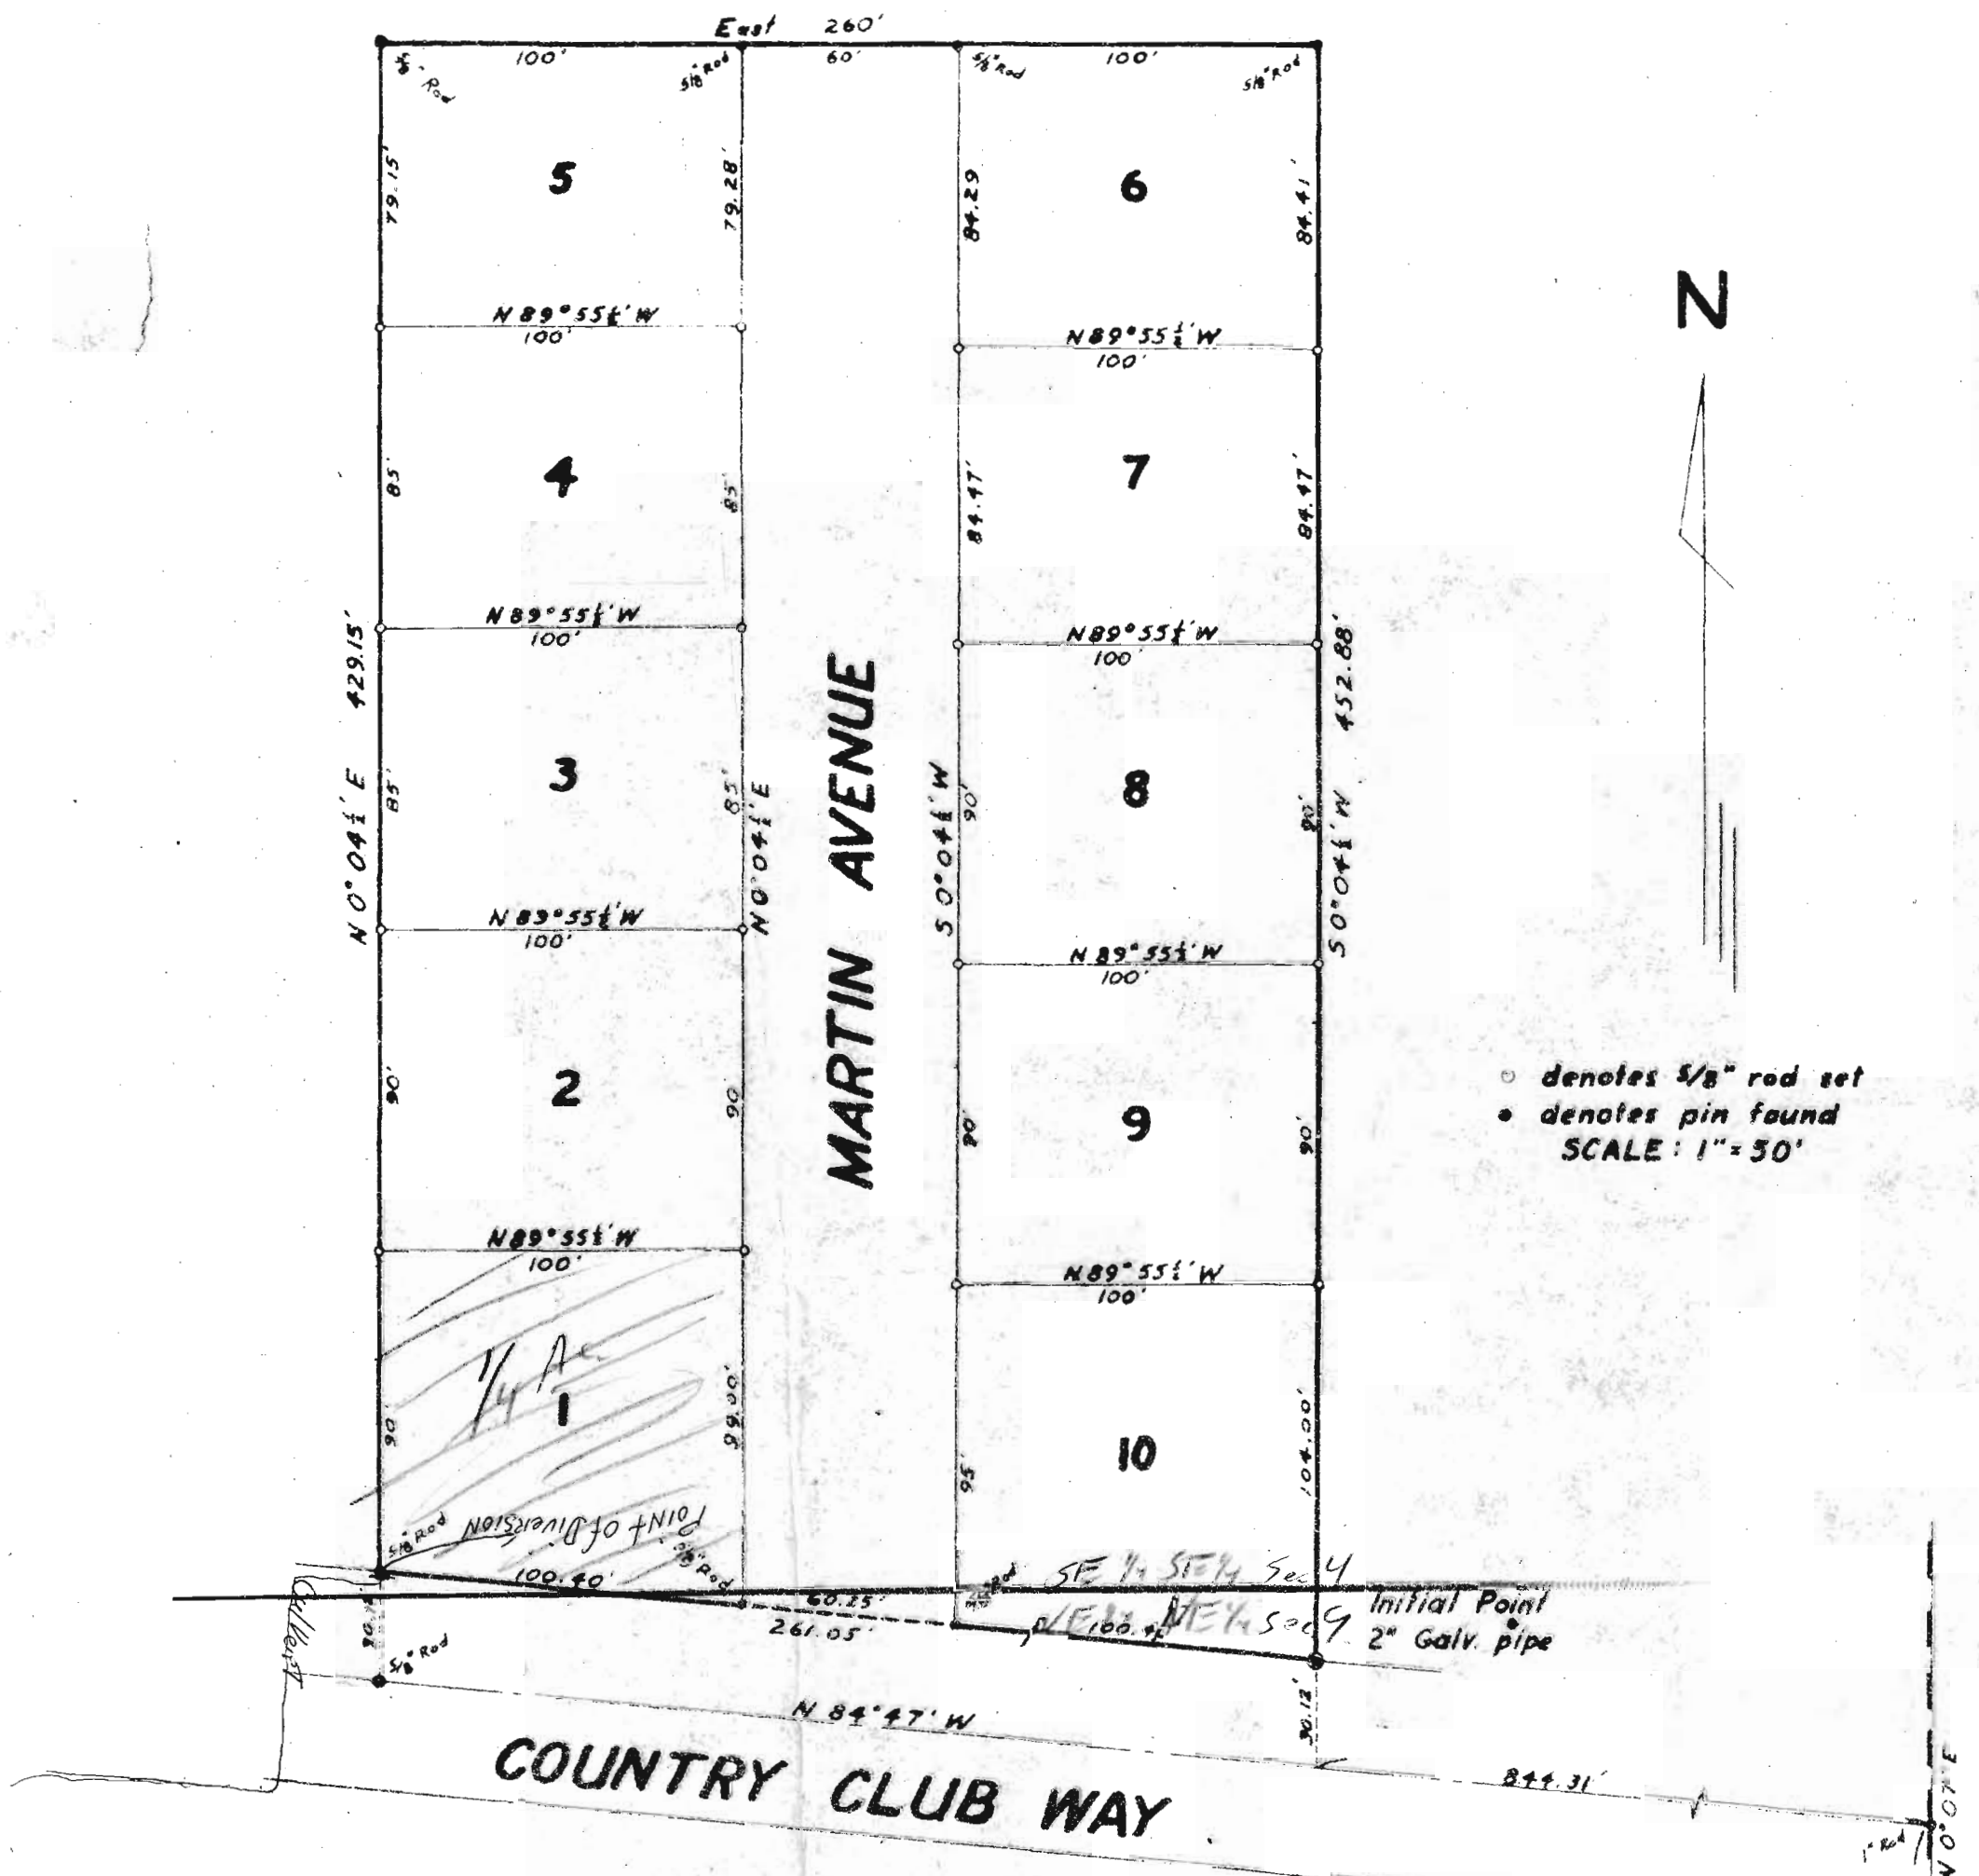

○ denotes 5/8" rod set  
● denotes pin found  
SCALE: 1" = 50'

This plat and dedication approved this 23<sup>rd</sup> day of April A.D. 1959.

Melvin Hawkins  
County Commissioner

Walter Schmitt  
County Commissioner

B. B. Perkins  
County Judge

B. M. Martin  
Planning Commission President

C. C. Baker  
Planning Commission Secretary

Richard W. ...  
County Assessor

Charles C. Hansen  
County Surveyor

I hereby certify that all taxes and assessments against said property have been paid.

I hereby certify a true copy of

Application No. 41406  
Permit No. 30929

[Signature]  
Sheriff and Tax Collector

S.E. Corner of  
Prier Scott  
D.L.C. No. 44