


T19S. R12W

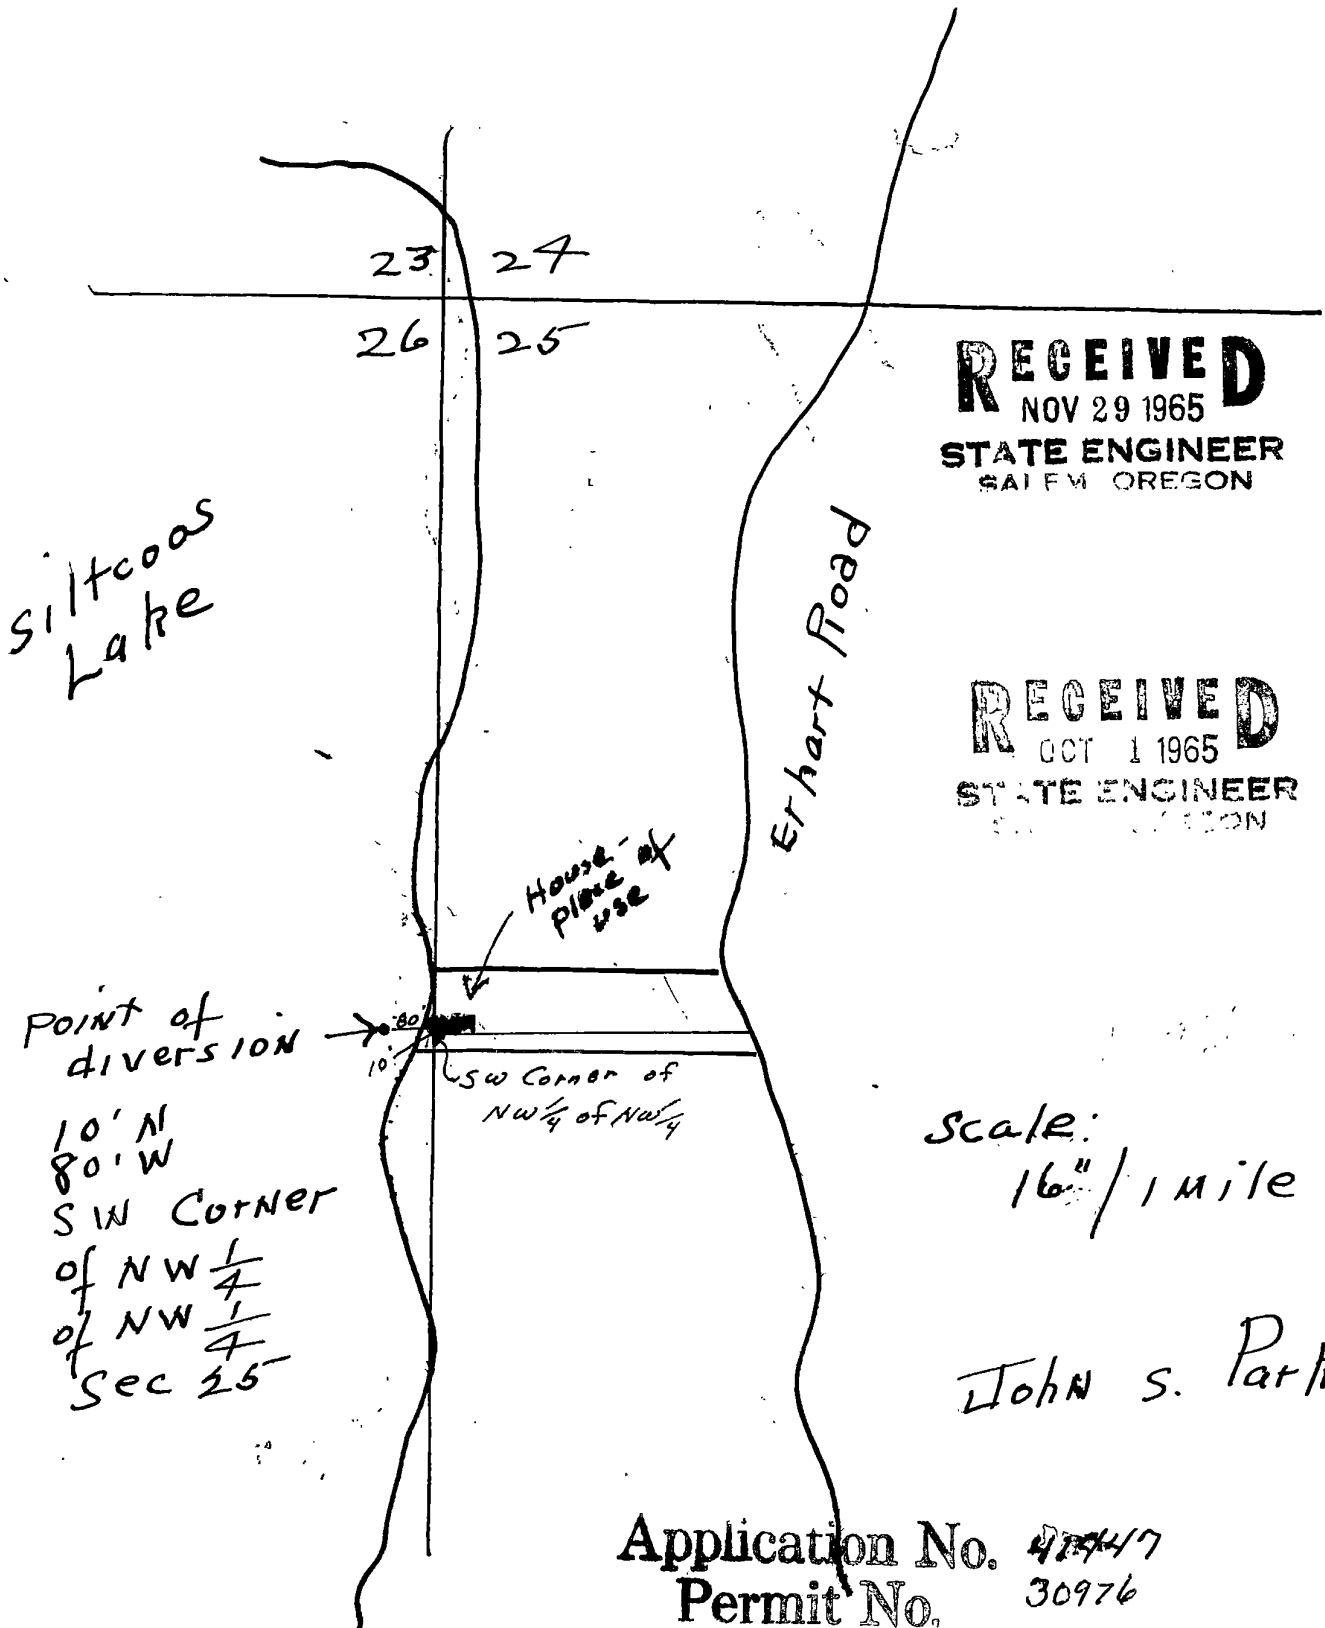

RECEIVED
NOV 29 1965
STATE ENGINEER
SALEM OREGON

RECEIVED
OCT 1 1965
STATE ENGINEER
SALEM OREGON

Scale:

John S. Parker

Application No. 42747
Permit No. 30976