


RECEIVED
OCT 18 1965
STATE ENGINEER
SALEM OREGON

T. 38 S., R. 1 W., WM

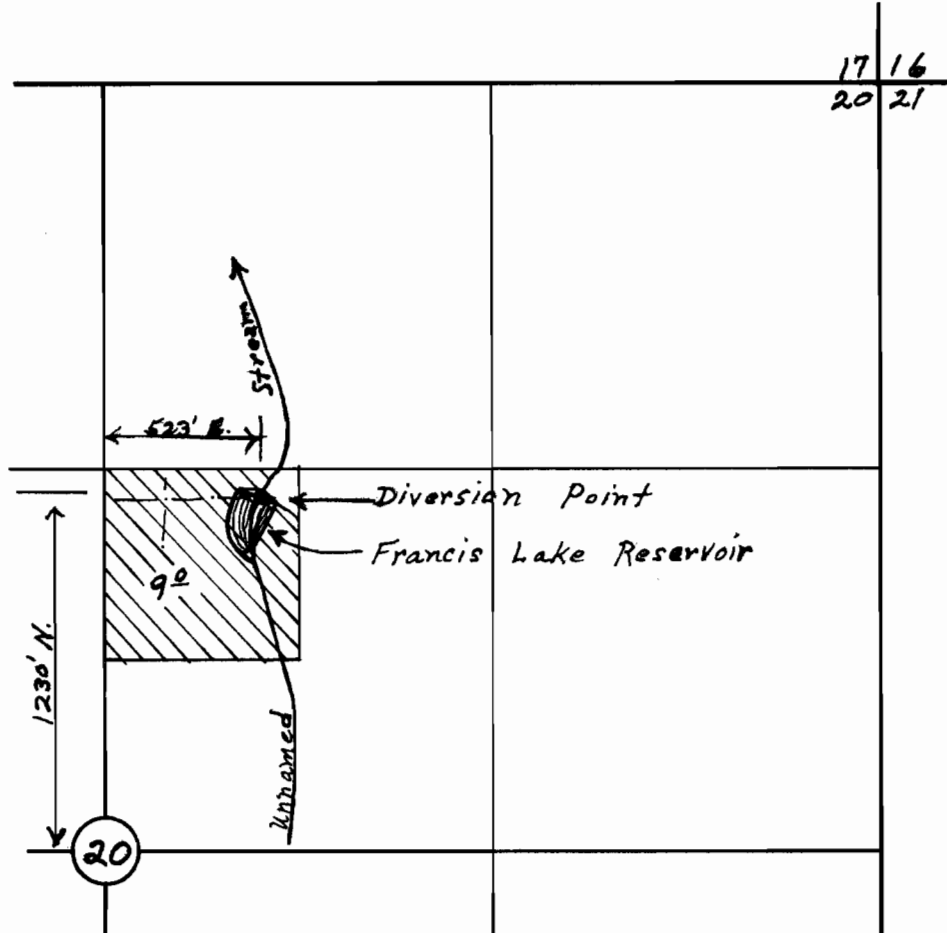

Jean L. Francis

Oct. 15, 1965

Scale: 8" = 1 mile

Application No. 41537, R-41539
Permit No. 30988, R-4677