


R-4762
31342
36-7-2

T. 36 S. R. 7 W. W.M.

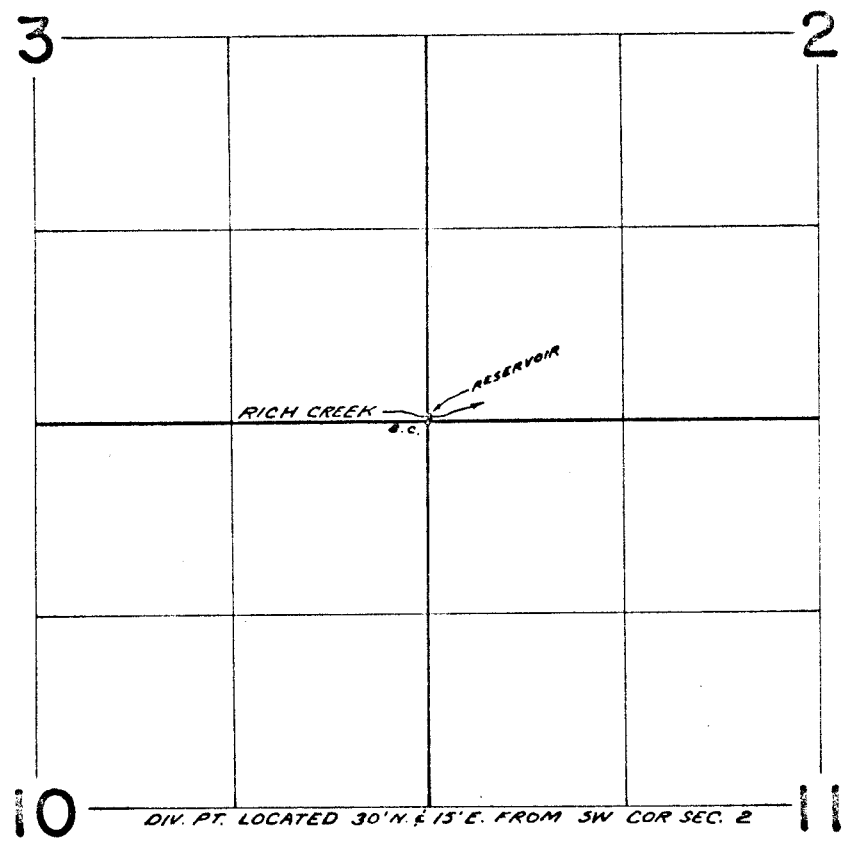

FINAL PROOF SURVEY UNDER

Application No. ⁴²⁴⁴⁰ R-42551 Permit No. ³¹³⁴² R-4762
IN NAME OF

HARRY E. HALL

Surveyed JUN. 6 1969, by D. BUELL