


31360
32-5-21

T.36 S.R.5 W.W.M.

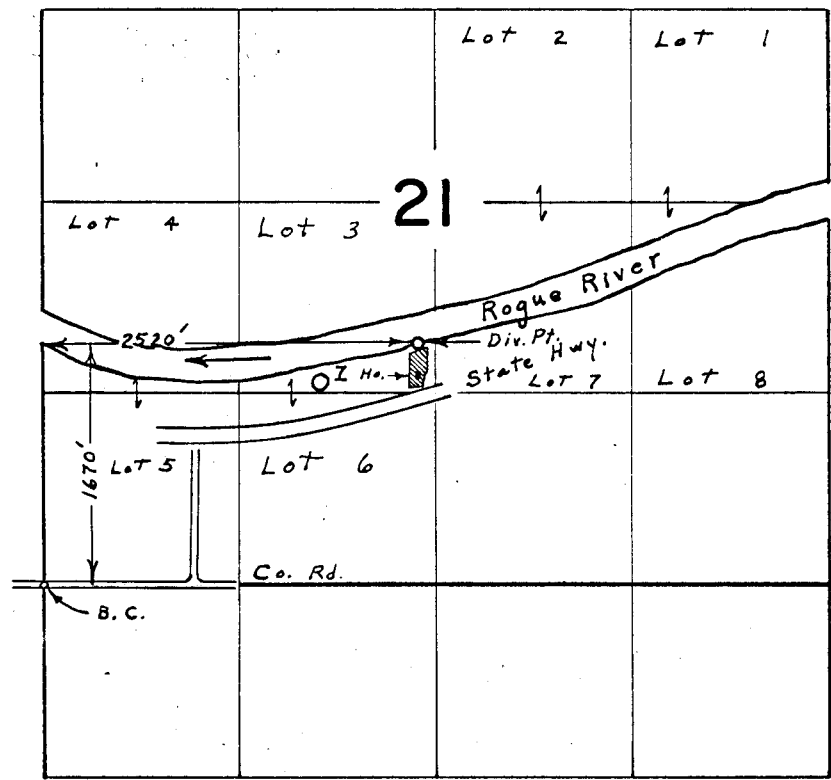

FINAL PROOF SURVEY UNDER

Application No. 41999 Permit No. 31360
IN NAME OF

ERNEST F. KROEGER

Surveyed Aug. 24, 1967, by L. E. Gauld