


31434 15
36-6-29

T. 36 S. R. 6 W. W.M.

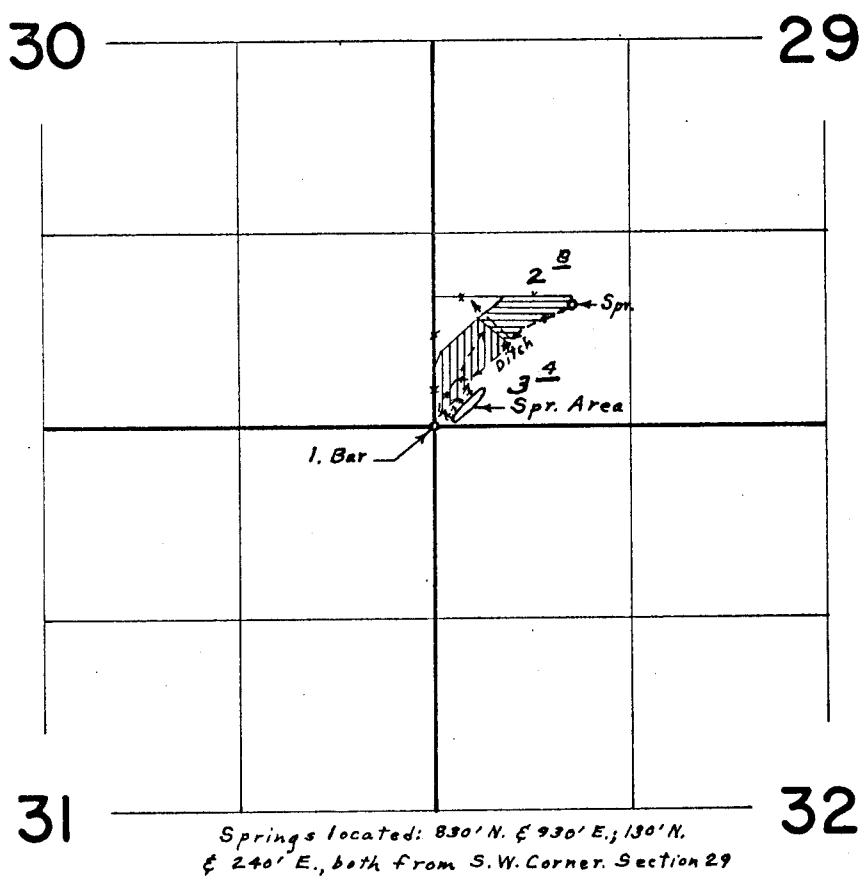

FINAL PROOF SURVEY
UNDER
Application No. 42003 Permit No. 31434
IN NAME OF
WILLIAM E. & MARY A. PHILLIPS
Surveyed April 30, 1970, by L. E. Gould