


S.33. T. 39 S. R.3 W W.M.

S.33 - T. 39 S. R.3 W. W.M. JACKSON CO., OREGON.

Center Sec Corner
3/4" pipe Driven stake

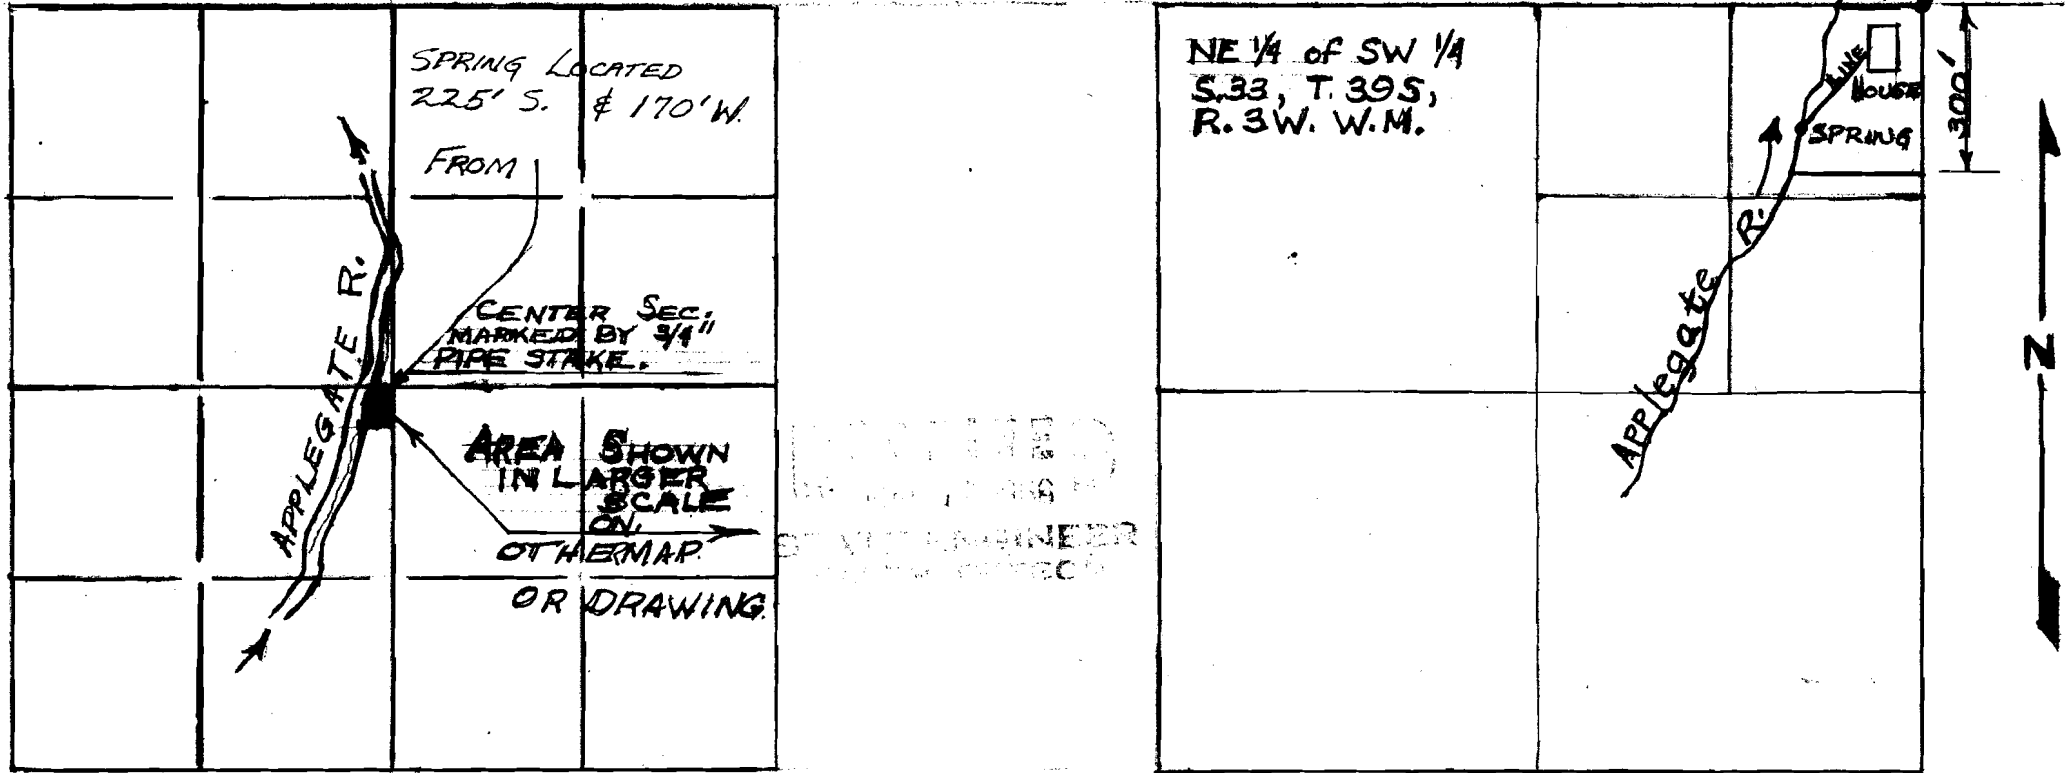

SPRING LOCATED
225' S. & 170' W.

FROM

CENTER SEC.
MARKED BY 3/4"
PIPE STAKE.

AREA SHOWN
IN LARGER
SCALE
ON
OTHER MAP

OR DRAWING.

NE 1/4 of SW 1/4
S.33, T. 39 S,
R. 3 W. W.M.

HOUSE
SPRING

APPLEGATE R.

300'

2

Scale 4" = 1 Mile

Application No. 42005
Permit No. 31436

Norman Buch 3/16/66