


31471  
36-6-25

# T. 36 S. R. 5 & 6 W. W. M.

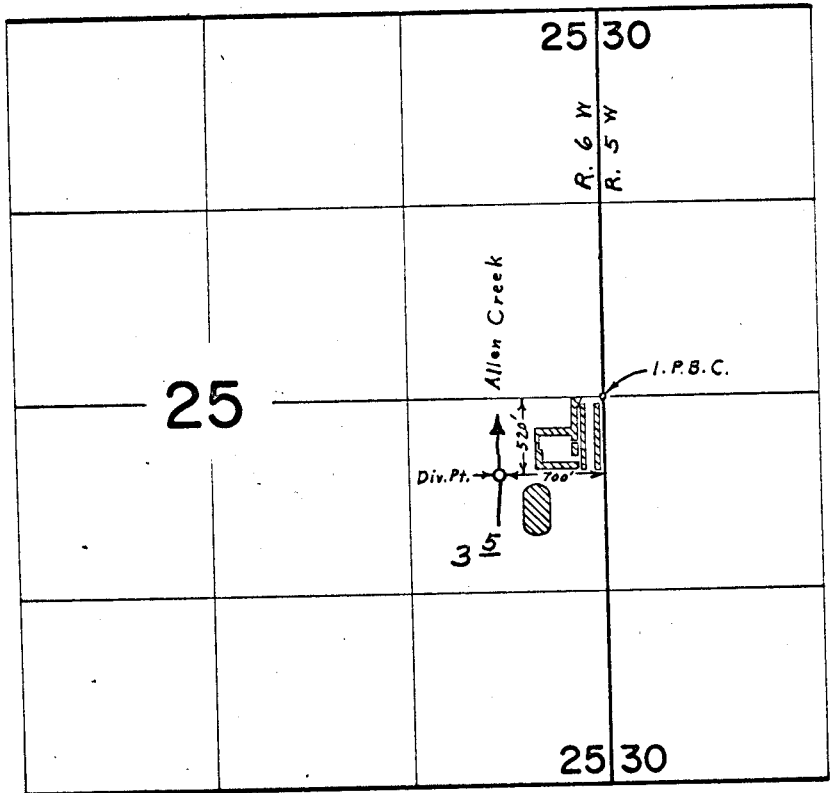

## FINAL PROOF SURVEY UNDER

Application No. 42042 Permit No. 31471  
IN NAME OF

SCHOOL DISTRICT NO. 7

Surveyed Aug. 29, 1967, by L. E. Gould