


T. 36 S. R. 6 W. W. M.

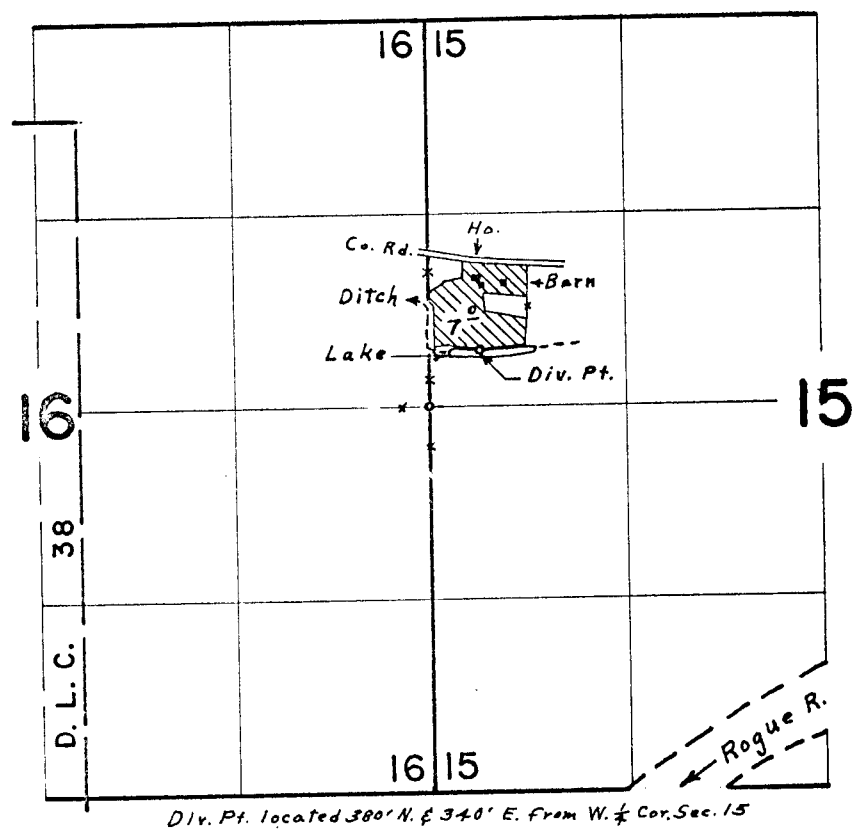

FINAL PROOF SURVEY

UNDER

Application No. 42056 Permit No. 31480

IN NAME OF

SALVATORE JOHN & CATHERINE FULCO

Surveyed April 30, 1970, by L. E. Gould