


R 11 W

1 6

Sec. 12 7

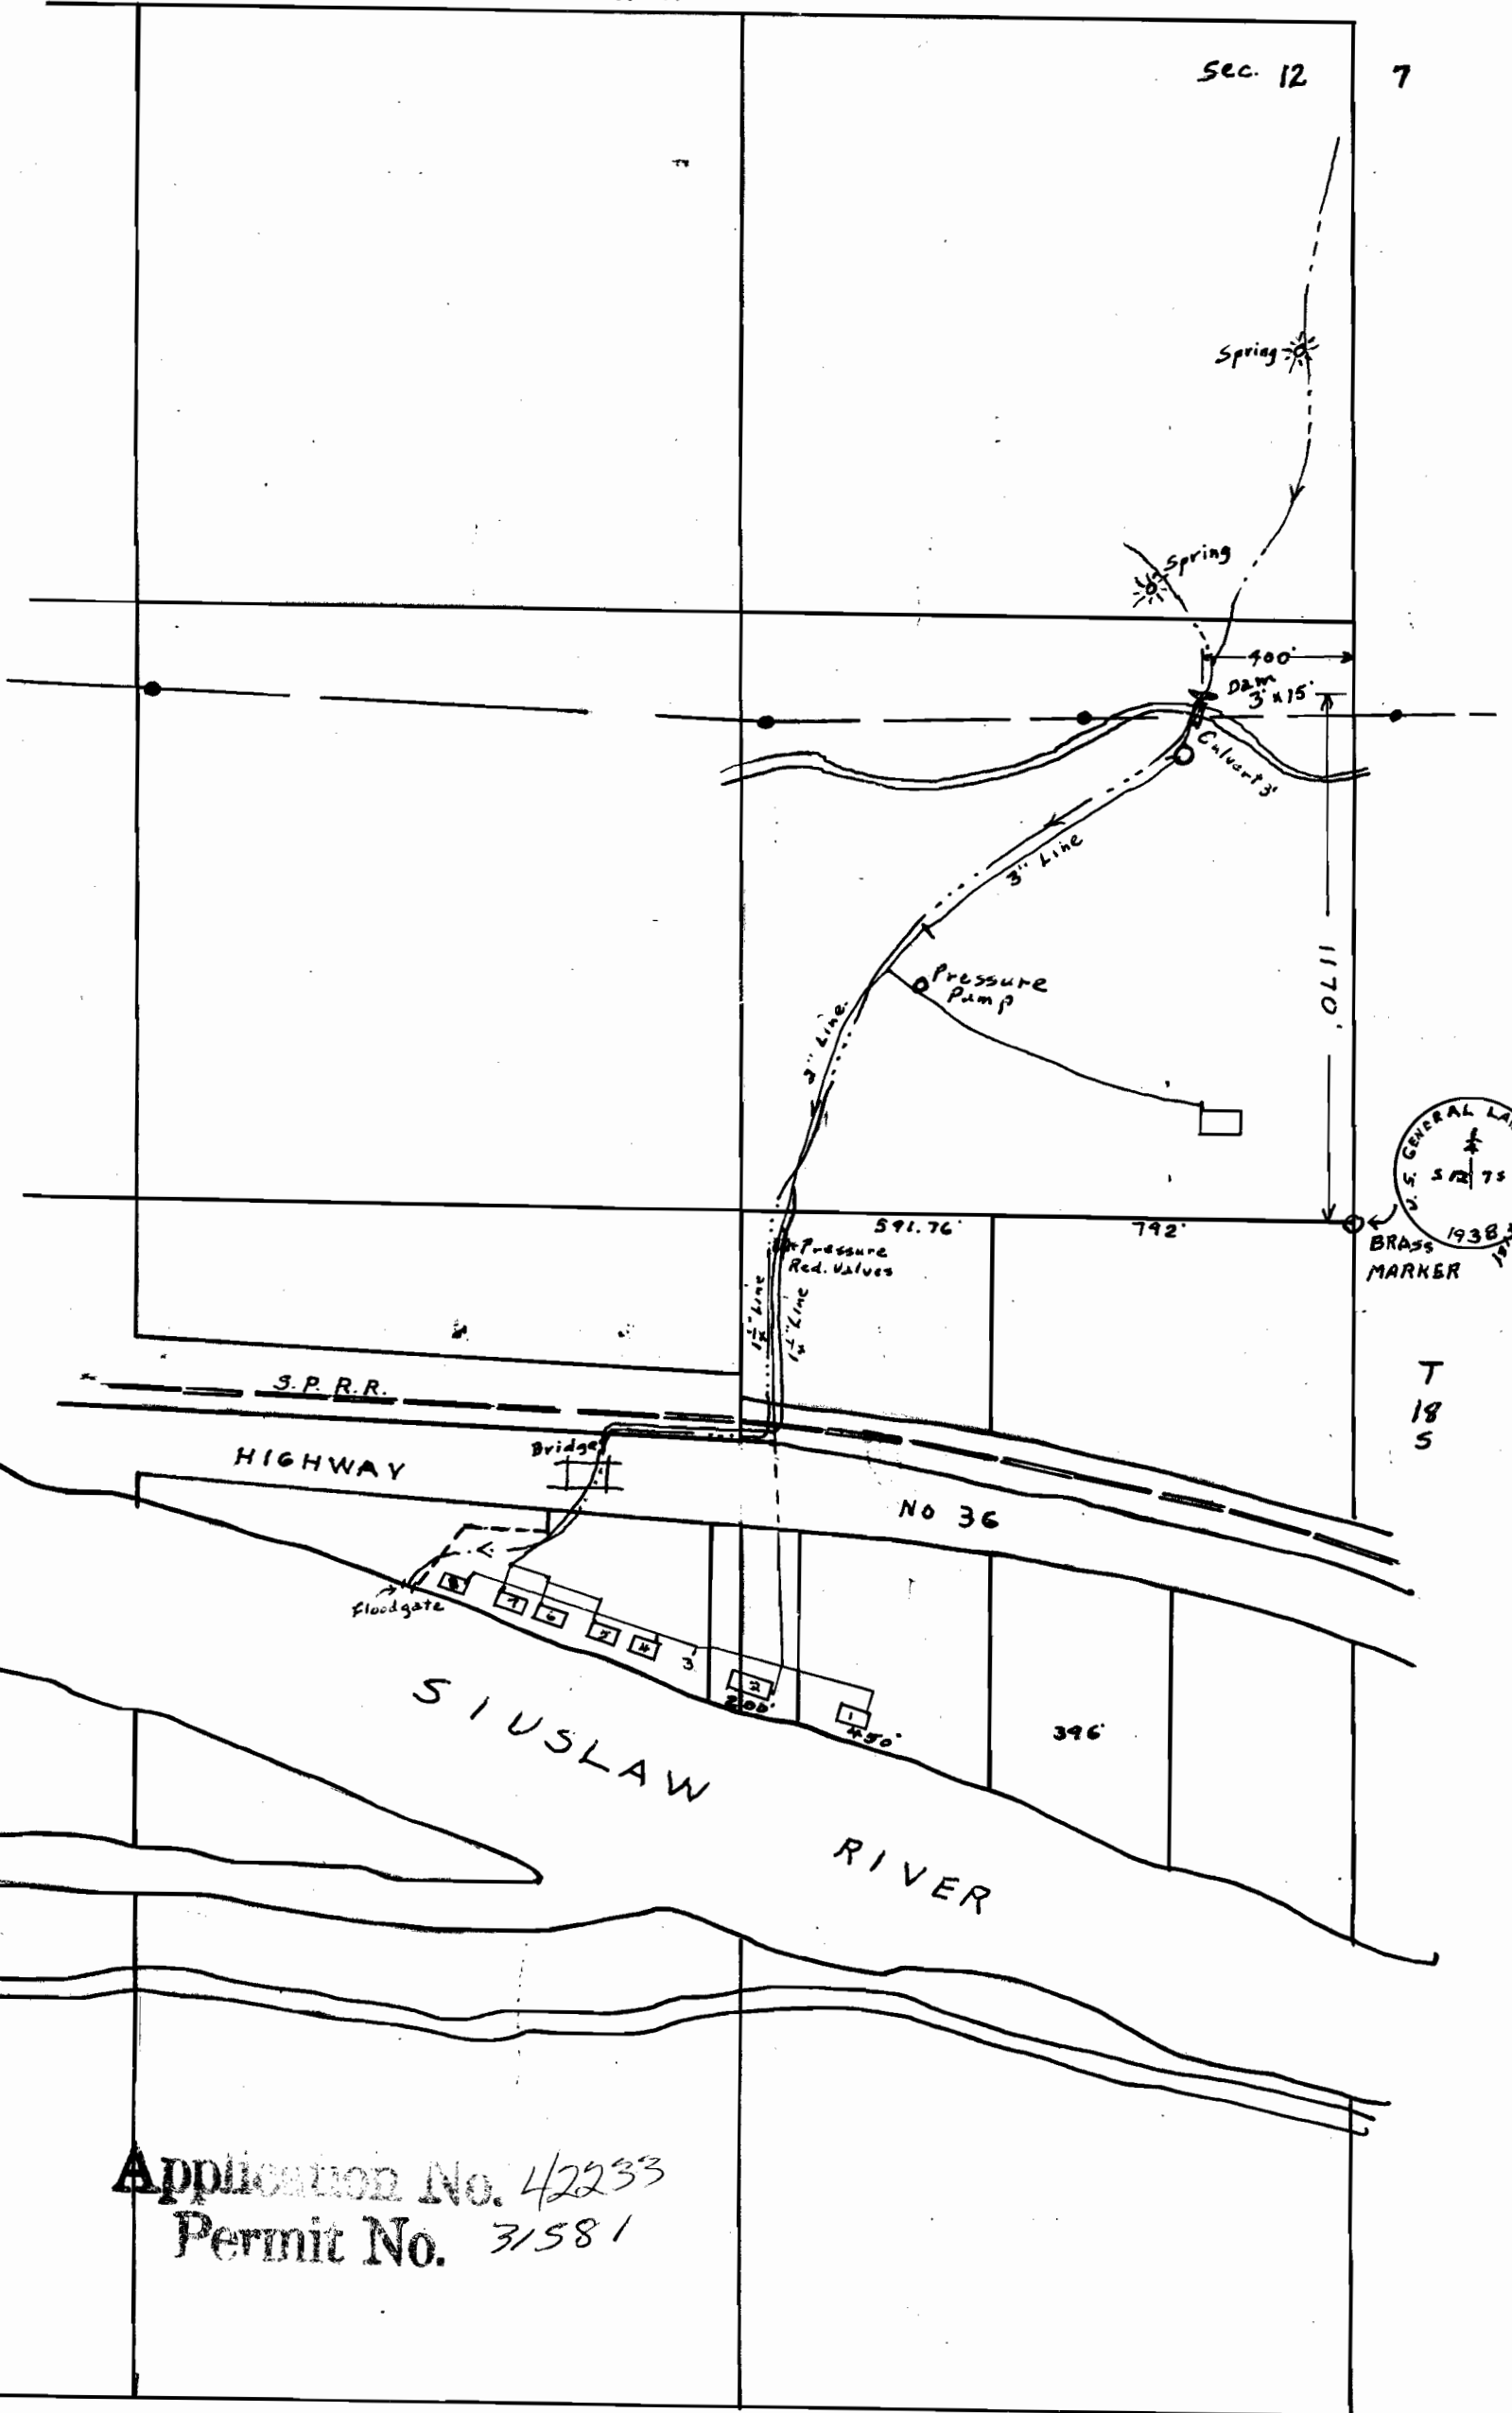

BRASS MARKER

T 18 S

Application No. 42233
 Permit No. 31581

R 11 W

1" = 400'