


T.7S.R.1W.W.M.

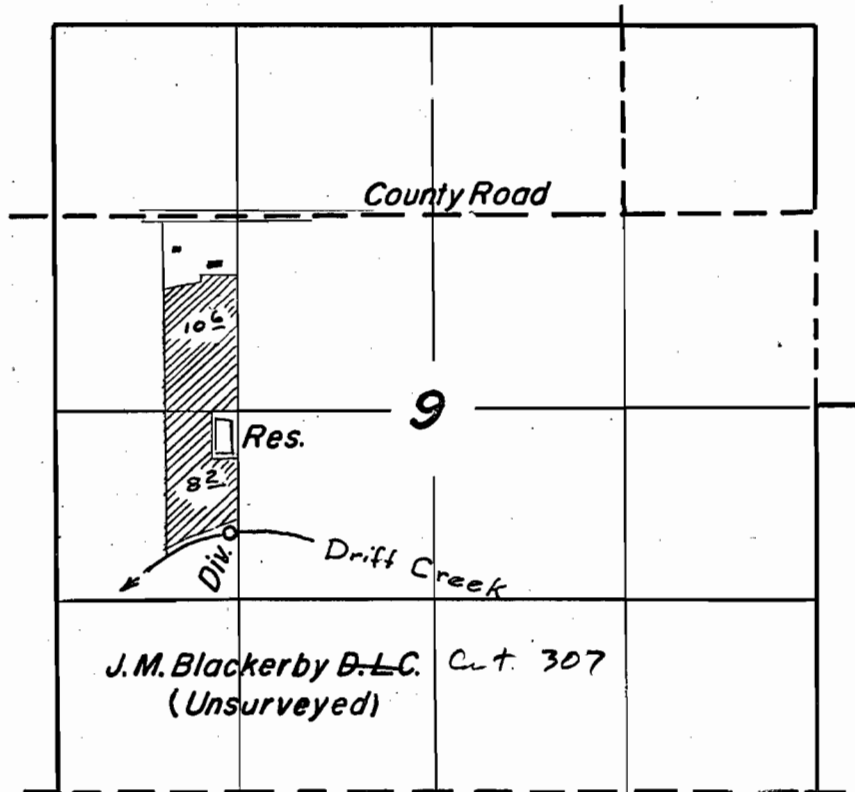

FINAL PROOF SURVEY
UNDER

Transfer V-21
R-37905 R 3091
Application No. 37906 Permit No. 28241
IN NAME OF

Alfred Von Flue

Surveyed June 11, 1964, by *Floyd L. Siegmund*

42383
Application No.
Permit No.
31662