


# T.36S.R.5W.W.M.

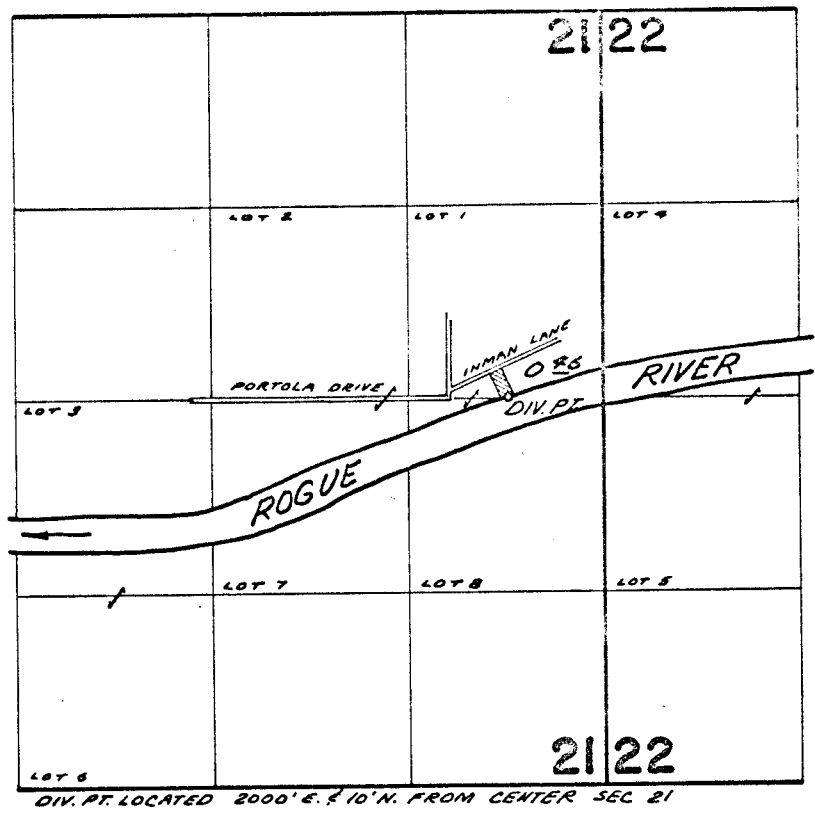

## FINAL PROOF SURVEY UNDER

Application No. 42633 Permit No. 31706  
IN NAME OF

MILNER L. LARSON

Surveyed JUN 7 1969, by D. BUELL