


T. 34 S. R. 6 W. W. M.

RECEIVED

DEC 13 1974

WM. DIST. 14
GRANTS PASS, ORE.

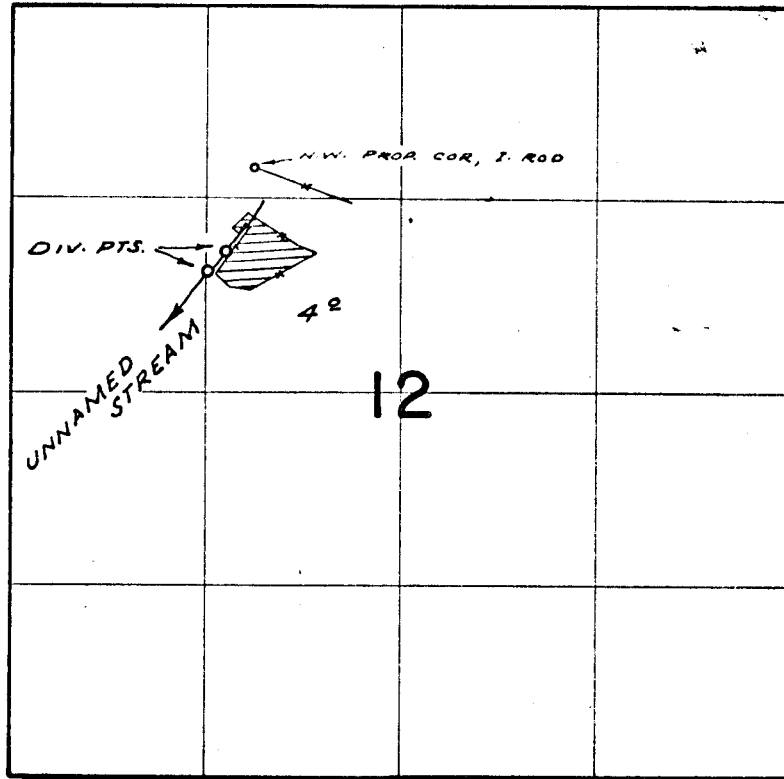

DIV. PTS. LOC: 1680'S. & 1180'W ; 1810'S. & 1310'W, BOTH
FROM N & COR. SEC. 12

FINAL PROOF SURVEY
UNDER

Application No. 42464 Permit No. 31760
IN NAME OF

ANN L. SLOAN

Surveyed APR. 12, 1972, by R. MUCKEN