


31823

35-8-21

T. 36 S. R. 5 W. W. M.

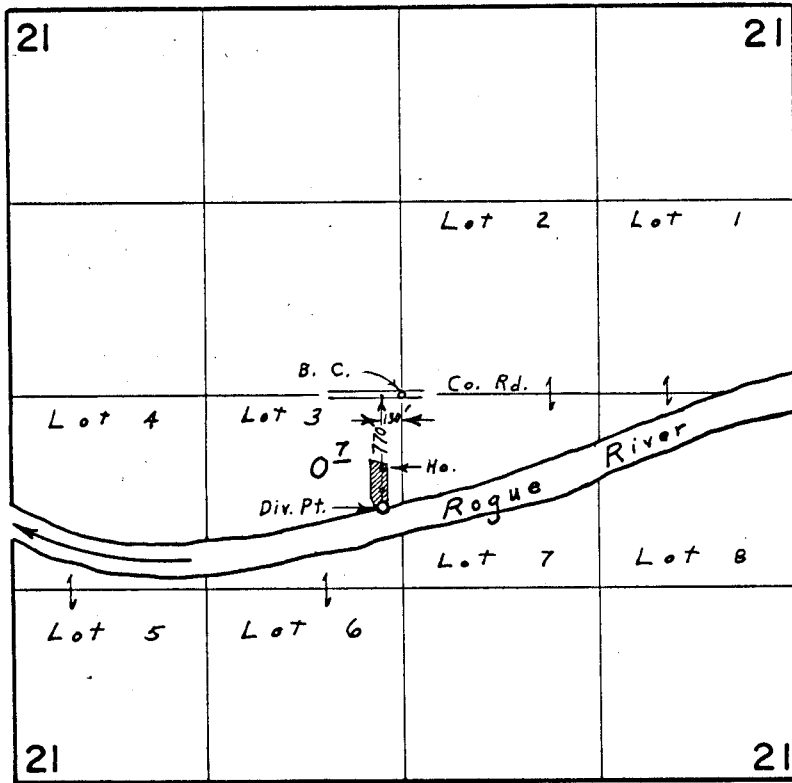

FINAL PROOF SURVEY UNDER

Application No. 42593 Permit No. 31823
IN NAME OF

RALPH R. HEITSTUMAN

Surveyed Aug. 24, 1967., by L. E. Gould