

B-161
31829


37-7-11

T.37S. R.7W. W.M

RECEIVED

NOV 24 1976

WM. DIST. 14
GRANTS PASS. ORF

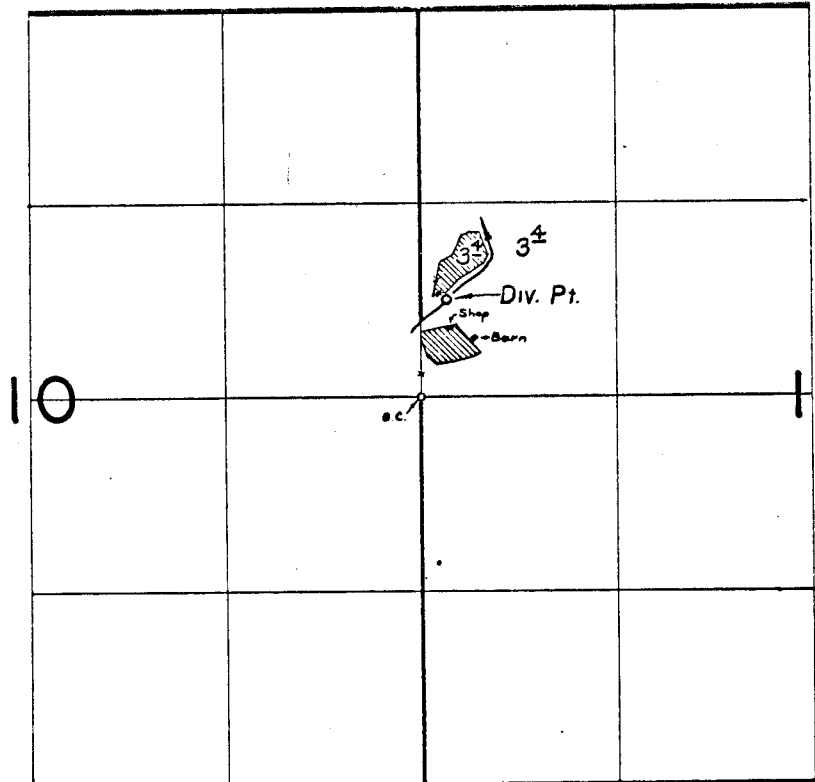

DIV. PT. LOC: 660' N. AND 180' E. FROM W. 1/4 COR. SEC. 11

FINAL PROOF SURVEY
UNDER

Application No. 42604 *Transfer B-161* Permit No. 31829
IN NAME OF

LEONARD F. BUCHANAN

Surveyed MAY 23, 1974, by L.E. GOULD

P.T.S. 1974-K Jaf.