


31843

31843

T. 36 S. R. 5 W. W. M.

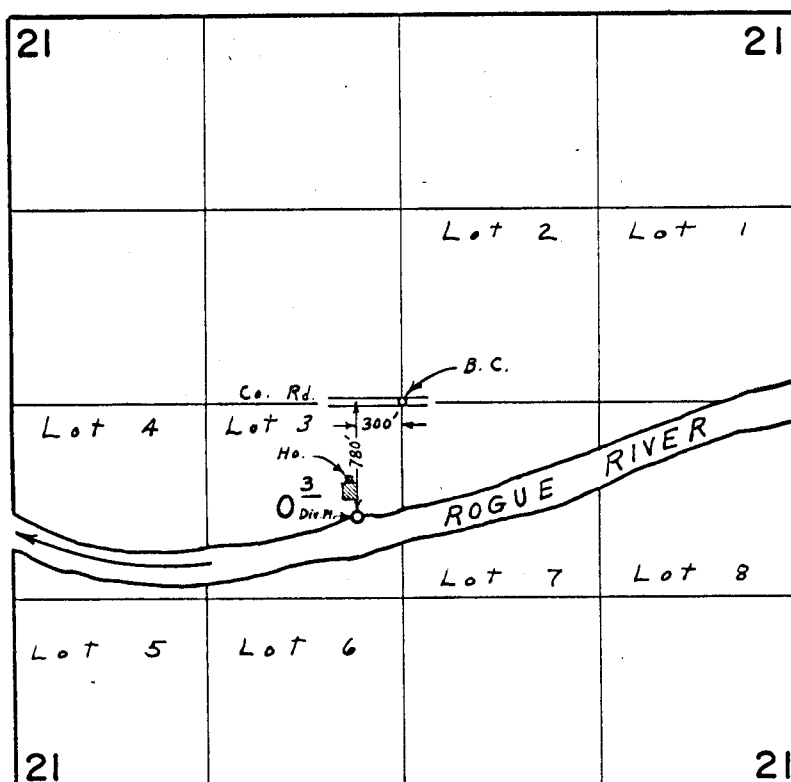

# FINAL PROOF SURVEY UNDER

Application No. 42627 Permit No. 31843  
IN NAME OF

ALBERT HERRICK

Surveyed Aug. 24, 1967, by L. E. Gould