

31867


T.37S. R.7W. W. M.

RECEIVED

NOV 24 1976

WM. DIST. 14  
GRANTS PASS. ORE.

31-1-1

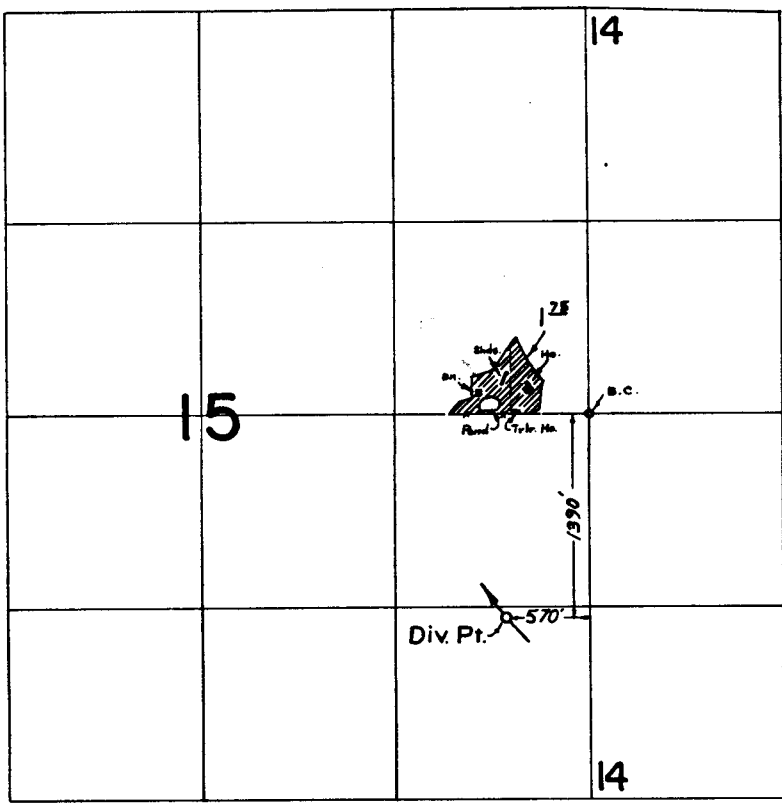

**FINAL PROOF SURVEY**  
UNDER

Application No. 43229 Permit No. 31867  
IN NAME OF

MAYNARD & VIVIAN ZERLAUT

Surveyed MAY 23 1974 by L.E. GOULD

P.T.S. 1974-K *Yak*