


31993  
36-7-14

# T.36S.R.7W.W.M.

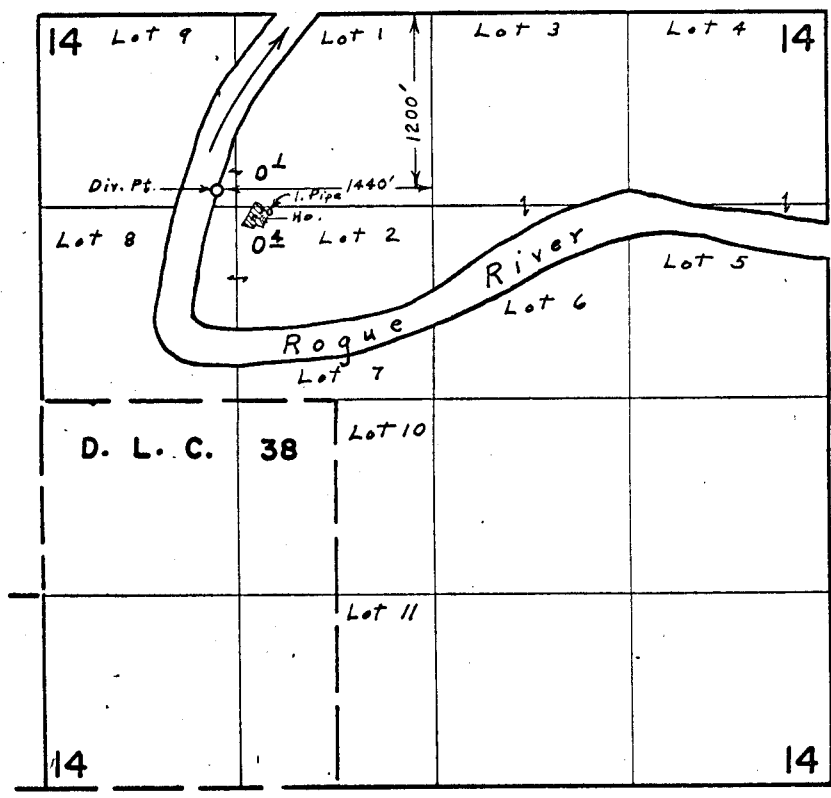

## FINAL PROOF SURVEY UNDER

Application No. 42792 Permit No. 31993  
IN NAME OF  
**HAROLD G. BELL**

Surveyed Aug. 30 1967, by L. E. Gould