


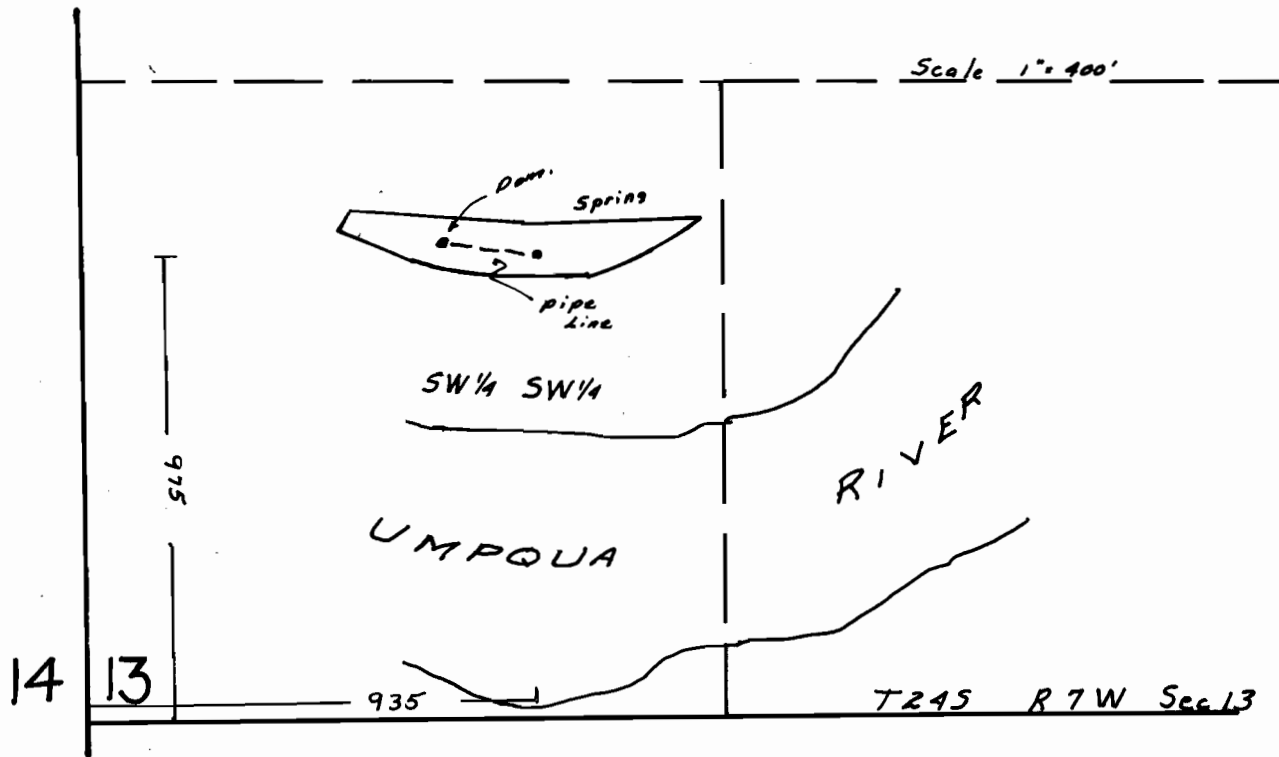

42991
32103