


T.35S.R.7W.W.M.

RECEIVED

DEC 13 1974

WM. DIST. 14
GRANTS PASS, ORE.

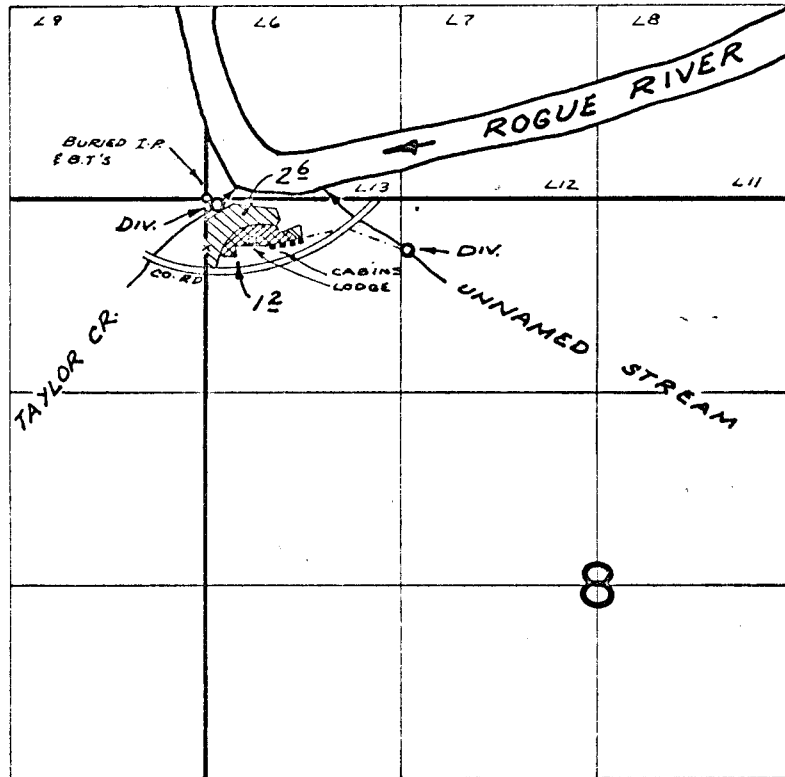

DIV. PTS. LOC1 UNN. STR - 350'S. & 1360'E; TAYLOR CR. -
40'S. & 70'E, BOTH FROM N.W. COR. SEC. 8

PRIMARY -  SUPPLEMENTAL - 

FINAL PROOF SURVEY
UNDER

Application No. ⁴³¹⁰²~~43254~~ Permit No. ³²²¹⁰~~32334~~
IN NAME OF

BERNARD ALBERT HANTEN

Surveyed APR. 19, 1972, by R. MUCKEN