


T.4S.R.2W.W.M.

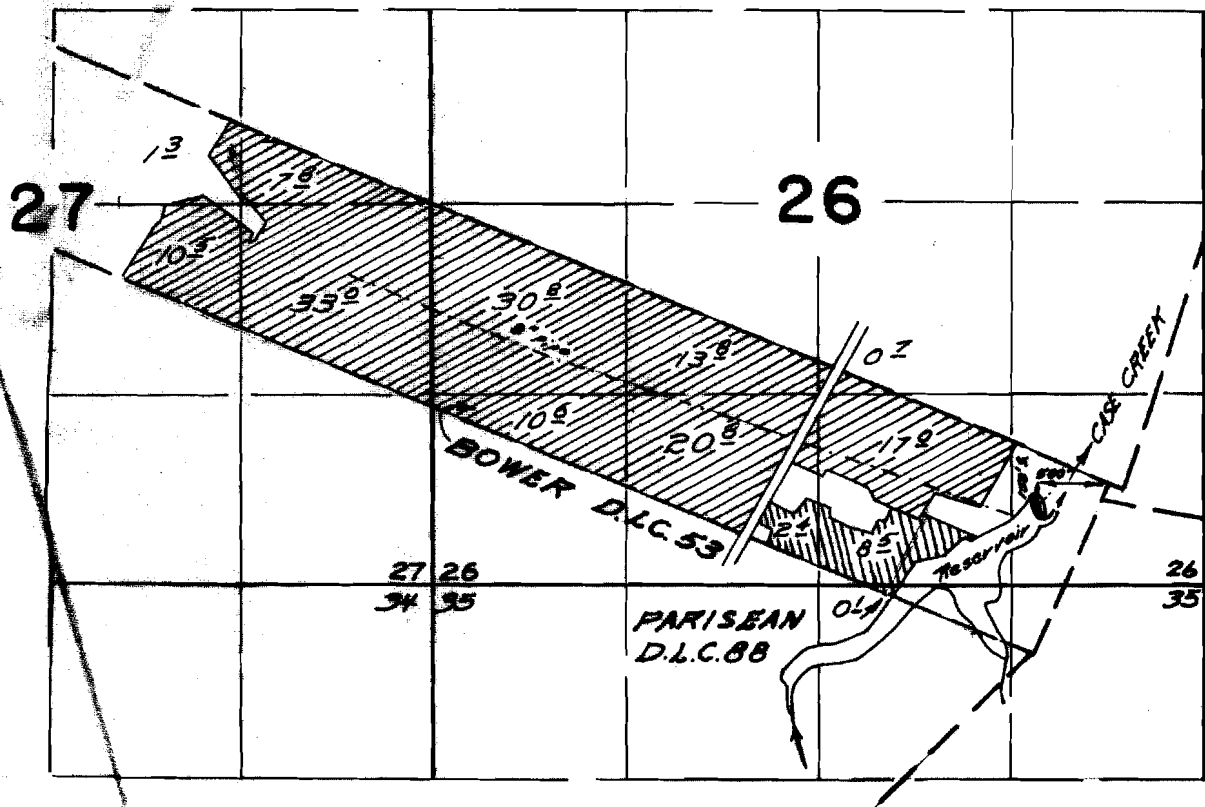

FINAL PROOF SURVEY
UNDER

Application No. R-43897 Permit No. R-4943
IN NAME OF

NEAL W. MILLER

Surveyed June 7, 1968 by H. J. Buppert