


G-3077
32377

T.39S.,R.5W.,W.M.

RECEIVED

NOV 24 1976

WM. DIST. 1A
GRANTS PASS OR

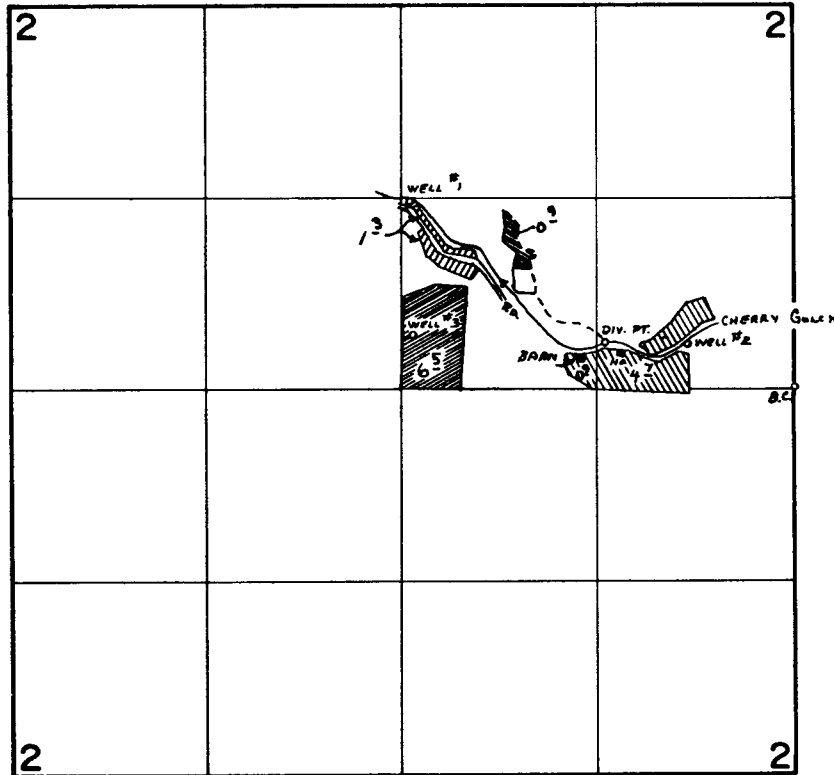

	WELL #1 (PRIMARY) - 1260' N AND 2610' W	} FROM E 1/4 COR OF SEC. 2
	WELL #2 (SUPPLEMENTAL) - 290' N AND 730' W	
	WELL #3 (SUPPLEMENTAL) - 360' N AND 2600' W	
	CHERRY GULCH DIV. (PRIMARY) - 300' N AND 1290' W	

FINAL PROOF SURVEY UNDER

Application No. 43297 Permit No. 32377
G-3302 G-3077
IN NAME OF

CLAIRE O. BROWN

Surveyed SEPT. 13 1974, by L. TOLL