


T.36S.R.5W.W.M.

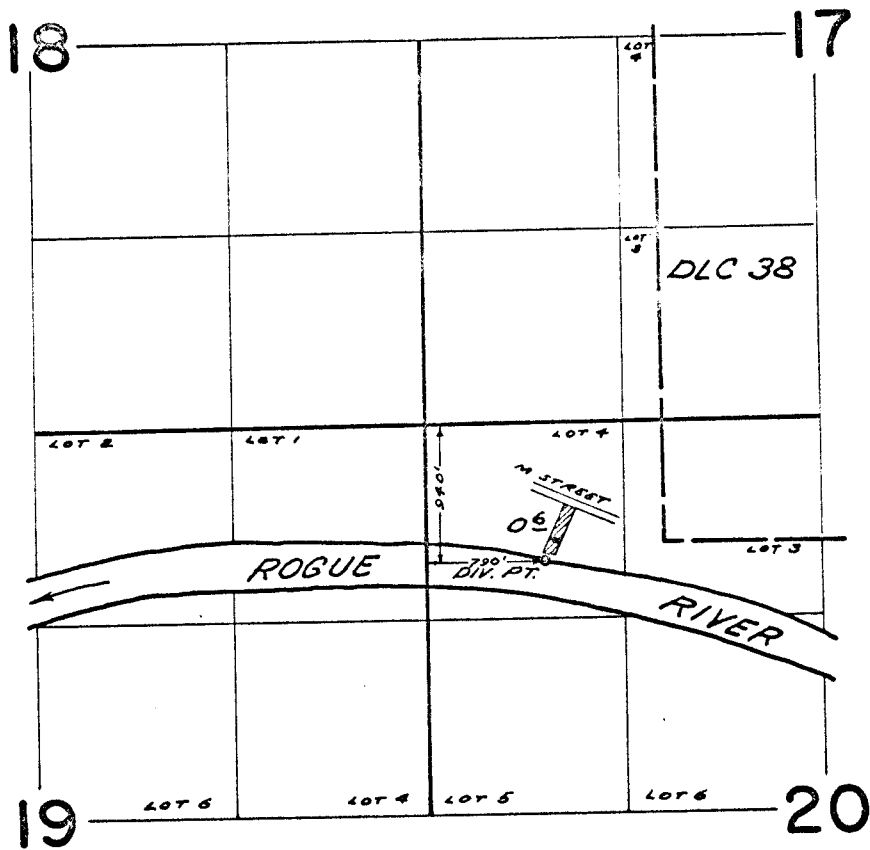

FINAL PROOF SURVEY
UNDER

Application No. 43305 Permit No. 32380
IN NAME OF

HIRAM A. AND HELENE S. NORTON

Surveyed JUN. 7 1969, by D. BUELL