


32500

T.36 S. R.5 W. W.M.

36-5-21

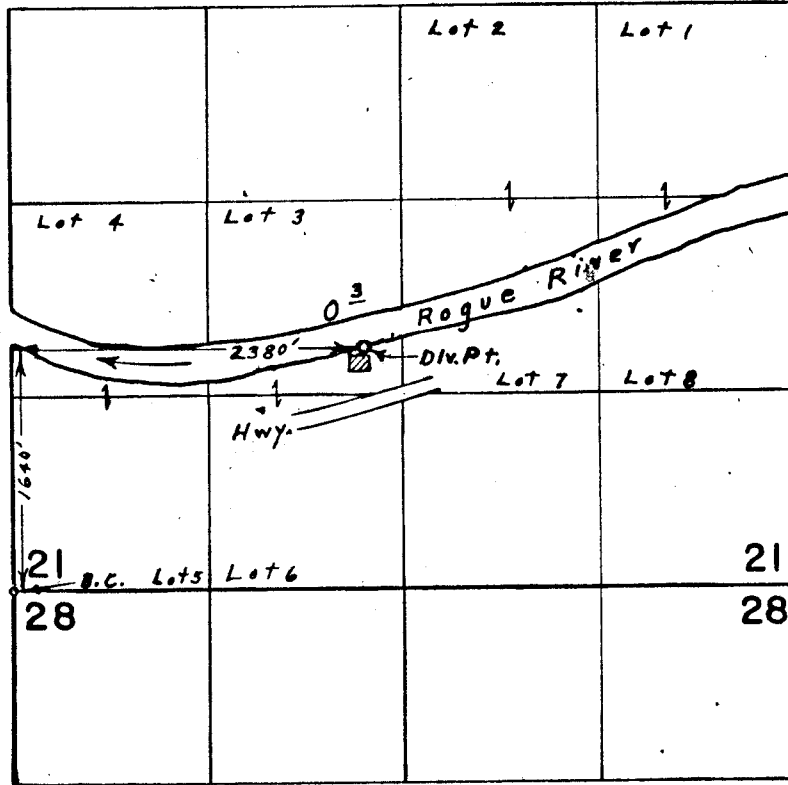

FINAL PROOF SURVEY
UNDER

Application No. 43448 Permit No. 32500
IN NAME OF

GENE H. ENDEMAN & JOHN A. DUKE

Surveyed April 23, 1974, by L. E. Gould