

MARION COUNTY

1" = 100'


See Map 8 4 E

1/16 Cor. 1/16 Cor.

00 129 00

See Map 32BC 8 4 E

See Map 8 4 E

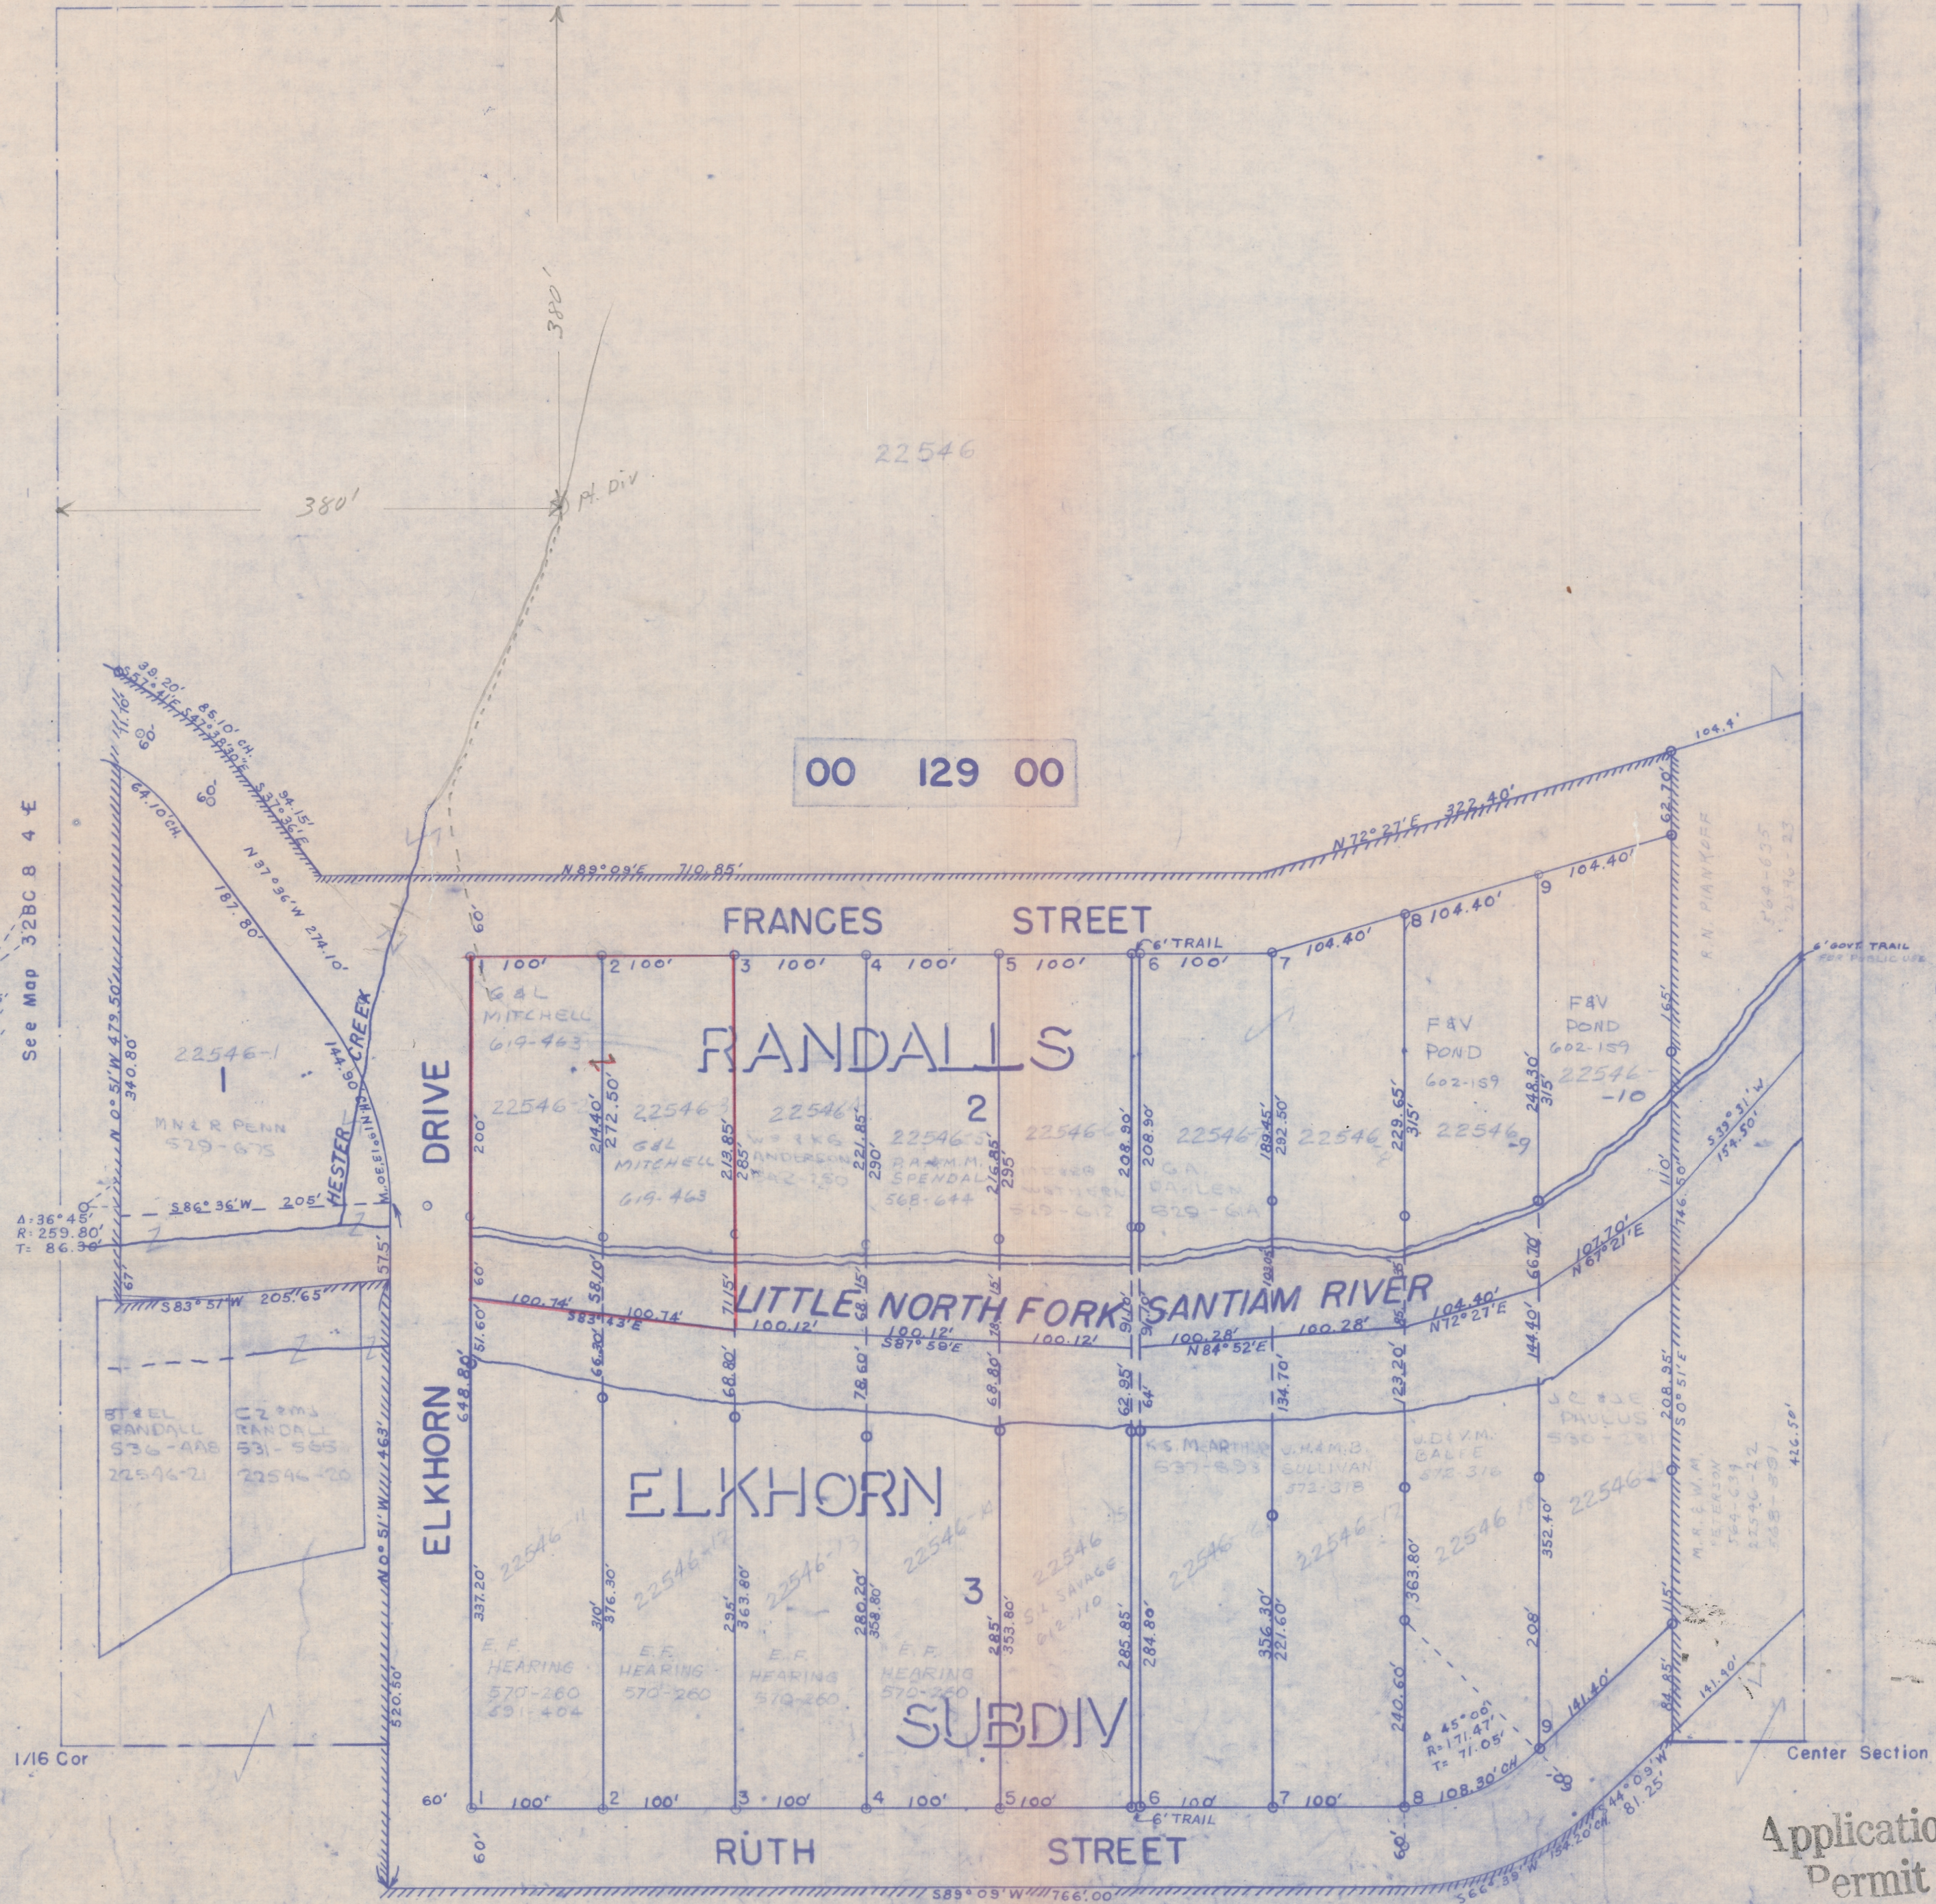


Application No. 43477
Permit No.

See Map 8 4 E

SE 1/4 NW 1/4 Sec 32 T8S R4E WM
MARION COUNTY

1" = 100'

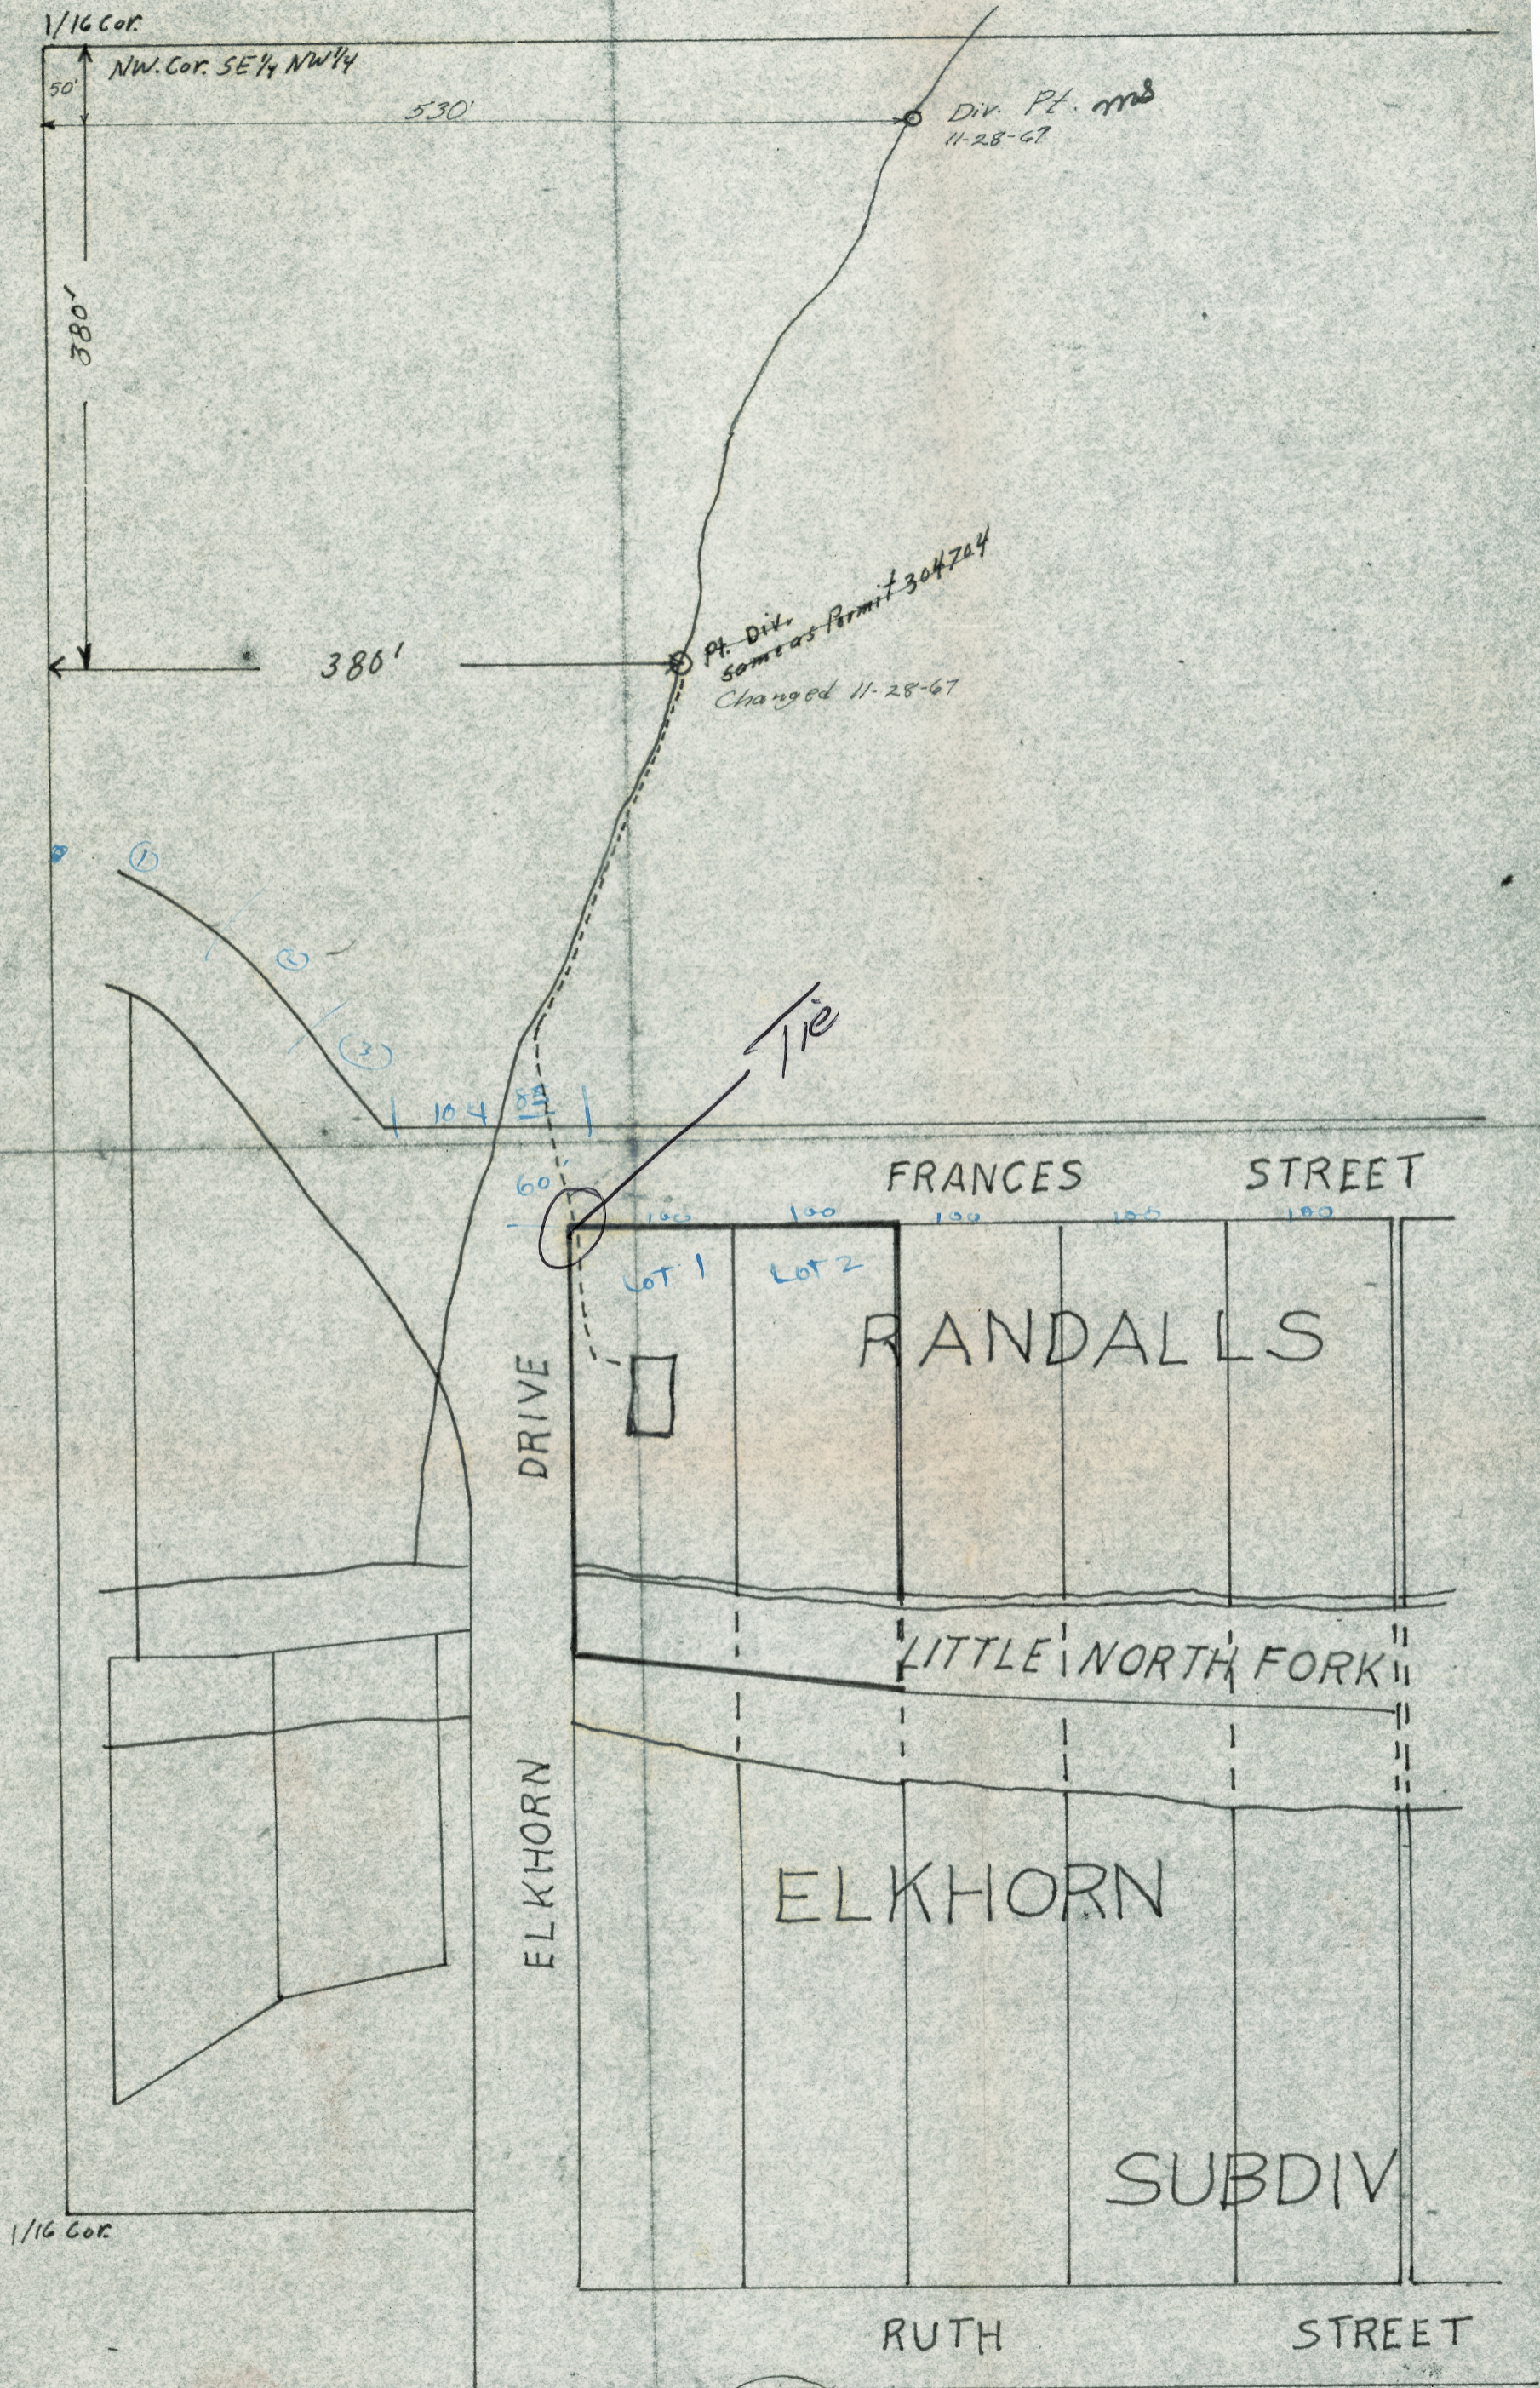

Application No. 43477
Permit No. 32519