


T. 36 S. R. 5 W. W. M.

RECEIVED

DEC 1 1977

WM. DIST. 14
GRANTS PASS, ORE

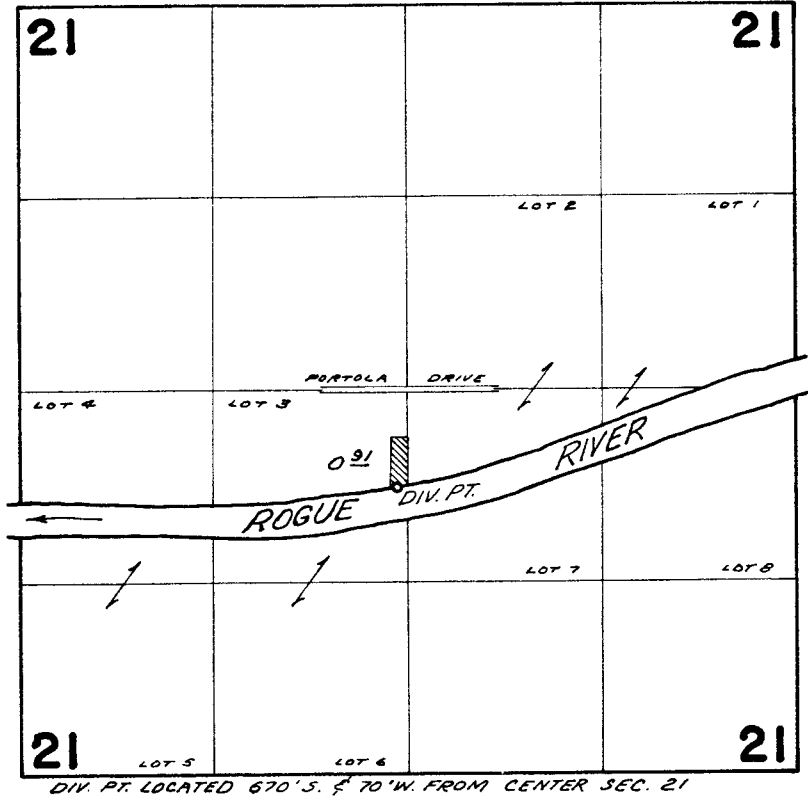

FINAL PROOF SURVEY
UNDER

Application No. 43494 Permit No. 32532
IN NAME OF

LLOYD M. HARLACHER

Surveyed JUN 6 1969, by D. BUELL

1969-A

37578